

34 88 17W

State of Kansas Survey  
WICHITA BRANCH

AFFIDAVIT AND COMPLETION FORM

ACO-1

This form must be filed in triplicate with the Kansas Corporation Commission, 200 Colorado Derby Building, Wichita, Kansas 67202, within five days after the completion of the well, regardless of how the well was completed. Circle one: Oil, gas, dry, SWD, OWWO, injection. Please type. Complete ALL sections. Applications must be filed for dual completion, commingling, salt water disposal and injection. Attach wireline logs (i.e. electrical log, sonic log, gamma ray neutron log, etc.) KCC#-(316) 263-3238.

OPERATOR Martin Oil Producers, Inc. API NO. 15 - 163 - 21,442

ADDRESS 1010 Union Center COUNTY Rooks

Wichita, Kansas 67202 FIELD \_\_\_\_\_

\*\*CONTACT PERSON \_\_\_\_\_ LEASE McMullen "A"

PHONE \_\_\_\_\_

PURCHASER \_\_\_\_\_ WELL NO. #3

ADDRESS \_\_\_\_\_ WELL LOCATION SE NE NW

\_\_\_\_\_ Ft. from \_\_\_\_\_ Line and

\_\_\_\_\_ Ft. from \_\_\_\_\_ Line of

DRILLING CONTRACTOR Big Springs Drilling, Inc. the SEC. 34 TWP. 8S RGE. 17W

ADDRESS P. O. Box 8287 - Munger Station

Wichita, Kansas 67208


PLUGGING CONTRACTOR Service Company

ADDRESS Hays, Kansas 67601

TOTAL DEPTH 3513 PBTD \_\_\_\_\_

SPUD DATE 10-26-81 DATE COMPLETED 11-1-81

ELEV: GR2025 DF KB

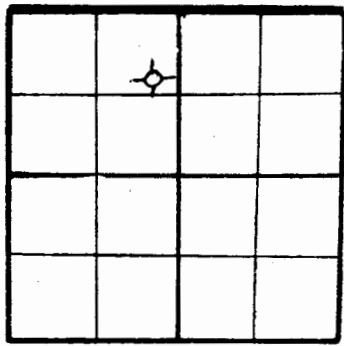

WELL PLAT  
(Quarter) or (Full) Section - Please indicate.

KCC \_\_\_\_\_  
KGS

DRILLED WITH (CABLE) (ROTARY) (AIR) TOOLS  
Report of all strings set — surface, intermediate, production, etc. (New)/(Used) casing.

Purpose of string	Size hole drilled	Size casing set (in O.D.)	Weight lbs/ft.	Setting depth	Type cement	Sacks	Type and percent additives
Surface	12 1/4"	8 5/8"	20#	225'	Common	165 SX	2% gel 3% ccl

LINER RECORD			PERFORATION RECORD		
Top, ft.	Bottom, ft.	Sacks cement	Shots per ft.	Size & type	Depth interval

TUBING RECORD		ACID, FRACTURE, SHOT, CEMENT SQUEEZE RECORD	
Size	Setting depth	Packer set at	Amount and kind of material used

RECEIVED  
STATE CORPORATION COMMISSION  
Depth interval treated  
**NOV 10 1981**  
CONSERVATION DIVISION  
Wichita, Kansas

Name of lowest fresh water producing stratum Sand Depth 50'  
 Estimated height of cement behind pipe Circulated

**WELL LOG**

Show all important zones of porosity and contents thereof; cored intervals, and all drill-stem tests, including depth interval tested, cushion used, time tool open, flowing and shut-in pressures, and recoveries.

SHOW GEOLOGICAL MARKERS, LOGS RUN, OR OTHER DESCRIPTIVE INFORMATION.

FORMATION DESCRIPTION, CONTENTS, ETC.	TOP	BOTTOM	NAME	DEPTH
Clay - Post Rock	0	40'		
Shale	40'	905'		
Sand	905'	1028'		
Shale	1028'	1328'		
Anhydrite	1328'	1369'		
Shale	1369'	2840'		
Shale & Lime	2840'	3060'		
Shale	3060'	3255'		
Shale & Lime	3255'	3495'		
Shale	3495'	3591'		
RTD	3591'			

USE ADDITIONAL SHEETS, IF NECESSARY, TO COMPLETE WELL RECORD.

A F F I D A V I T

STATE OF Kansas, COUNTY OF Sedgwick SS,

Paul A. Seymour, III OF LAWFUL AGE, BEING FIRST DULY SWORN UPON HIS OATH, DEPOSES AND SAYS:

THAT HE IS FOR Big Springs Drilling, Inc.  
 OPERATOR OF THE McMullen "A" LEASE, AND IS DULY AUTHORIZED TO MAKE THIS  
 AFFIDAVIT FOR AND ON BEHALF OF SAID OPERATOR, THAT WELL NO. #3 ON SAID LEASE HAS  
 BEEN COMPLETED AS OF THE 1st DAY OF November 19 81, AND THAT ALL  
 INFORMATION ENTERED HEREIN WITH RESPECT TO SAID WELL IS TRUE AND CORRECT.