


FORM 51

Section 17 Township 8 Range KANSAS 17W

Well No. #1 Schindler

Company Jones, Shelburne & Farmer.

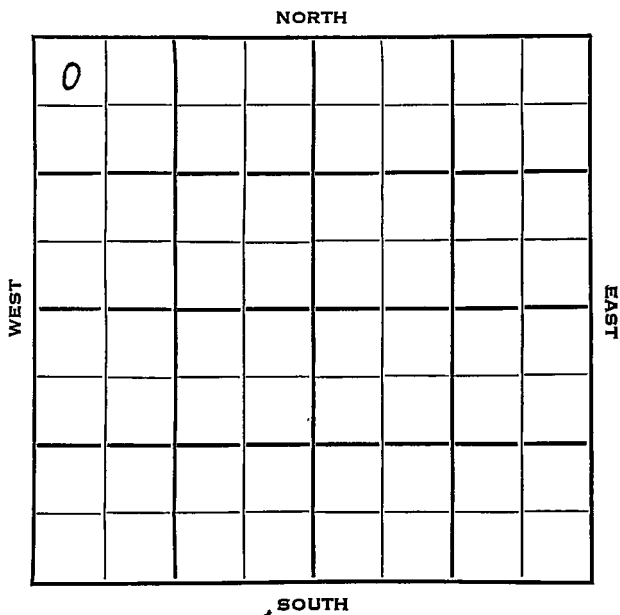

Sec. 17 Twp. 8 R. 17W

Well No. #1 Schindler Farm

Jones, Shelburne & Farmer Company

D & M Drlg. Contractor

Semi Wildcat.


330 Ft. from N. Line

_____ Ft. from S. Line

_____ Ft. from E. Line

330 Ft. from W. Line

NW NW NW

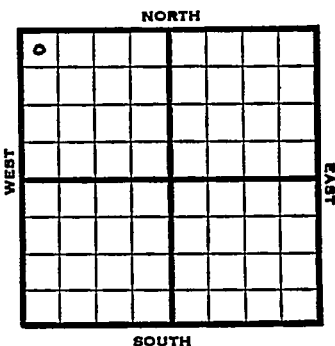

1953

Elev. 1879'

REPORT

8/12 Spud 8-10-53
8" @ 160'

8/19 Drlg. 3133'

8/26 Spud 8-10-53
D & A TD 3355 8" @ 160 Anhy 1290
Heeb 3018 Tor. 3043 Lans 3060
Arb. 3332
DST 3331-40 open 1 hr rec 5' mud 170#
TD 3355
D & A

ABANDONED

County _____ Rocks Rocks State Kansas

Sec. 17 (Blk. 8 (Sur. 17W (Twp. _____) Rge.) _____) Map No. _____

Operator Jones, Shelburne & Farmer

Well No. 1 Farm Schindler

Elev. _____ Location NW NW NW

0					

330 Ft. From N Line NW

330 Ft. From W Line Quarter

1st. Report AUG 12 1953

Completion _____

Remarks _____

D & M Drlg. - Contr.

Spudding Date 8-10-53

Drlg. Data Semi Wildcat

8" @ 160

County _____ Rocks _____ State Kansas

Sec. 17 (Blk. 8) (Sur. 17W) (Twp. 8) (Rge. 17W) Map No. _____

Operator Jones, Shelburne & Farmer

Well No. 1 Farm Schindler

Elev. 1879 Location NW NW NW

0				

330 Ft. From N Line NW

330 Ft. From W Line Quarter

Ist. Report

Completion AUG 26 1953

Remarks Semi Wildcat

D & M Drlg. - Contr.

Spudding Date 8-10-53

Drlg. Data D & A TD 3355

8" @ 160 Anhy 1290 Heeb. 3018

Tor. 3043 Lans. 3060 Arb. 3332

DST 3331-40 open 1 hr. Rec. 5' mud

170# TD 3355

D & A