


Section 17 Township 8 Range 17W

Well No. #1 Schindler "B"

Company Herndon Drlg.

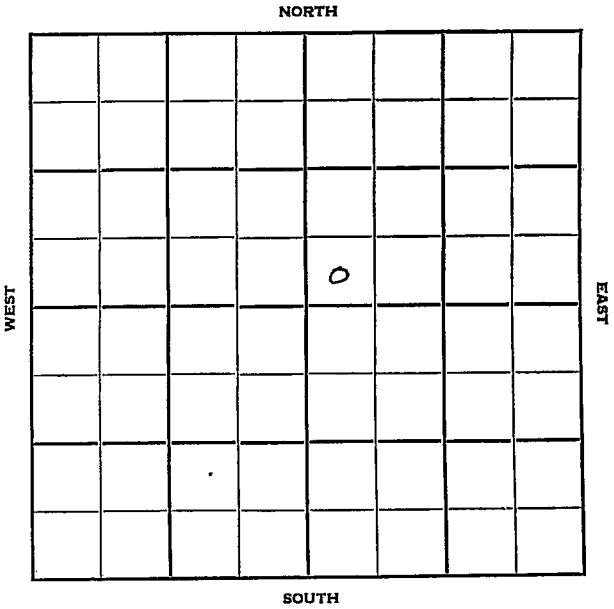

Sec. 17 Twp. 8 R. 17 W ✓

Well No. # 1 Schindler "B" Farm

Herndon Drlg. Company

Contractor

Wildcat


 Ft. from N. Line

330 Ft. from S. Line

 Ft. from E. Line

330 Ft. from W. Line

SW SW NE

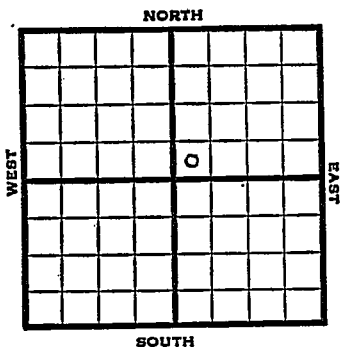

1951

Elev. 1921'

REPORT

4/4

Cellar & pits

5/2

Spud 4-13-51

D & A TD 3473'

13" @ 30 Anhy 1280' 8" @ 1285

SO 3120-34', 3142-50, 3204-13'

DST 3124-3224 open 1/2 hr. rec 15' mud

Top. 2836', Heeb 3048', Br. lime

3056', Lans. 3076', SSO 3271-80

Cong. 3374', Arb. 3438',

TD 3473'

D & A

ABANDONED

