


Section 17 Township 8 Range 16W

Well No. #1 Collman

Company K&E Drig.

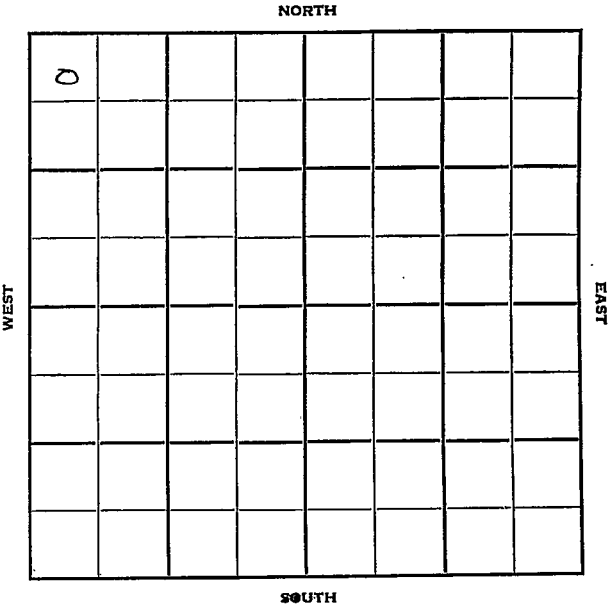

Rooks

KANSAS

Sec. 17 Twp. 8 R. 16 W

Well No. # 1 Collman Farm

K & E Drlg. Company

Contractor

Wildcat

330 Ft. from N. Line


_____ Ft. from S. Line

_____ Ft. from E. Line

330 Ft. from W. Line

NW NW NW

Sinclair DHM

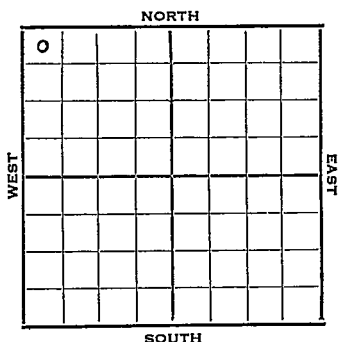

1951 Elev. 1832' REPORT

12/5 Location

1952

1/2

Spud 12-13-51

D&A TD 3342

8" @ 205

Top. 2726

Heeb. 2928

Lans. 2962

Arb. 3317

TD 3342

D&A

ABANDONED

County Rooks State KansasSec. 17 (Blk. Twp.) 8 (Sur. Rge.) 16W Map No. _____Operator K & E Drlg.Well No. 1 Farm CollmanElev. _____ Location NW NW NW

0							

330 Ft. From N Line NW330 Ft. From W Line Quarter1st. Report DEC 5 1951

Completion _____

Remarks Sinclair DEM

Spudding Date _____

Drlg. Data Wildcat

Location _____

J. E. TYRA

County Rooks State KansasSec. 17 (Blk.) 8 (Sur.) 16W Map No.Operator K & E Drlg.Well No. 1 Farm CollmanElev. 1832 Location NW NW NW

0									

330 Ft. From N Line NW330 Ft. From W Line Quarter

1st. Report

Completion JAN 2 1952Remarks WildcatSpudding Date 12-13-51Drlg. Data D & A TD 33428" @ 205 Top. 2726 Heeb. 2928Lans. 2962 Arb. 3317 TD 3342D & A

J. E. TYRA