


Section 17 Township 8 Range 18-W

Well No. #1 Banberry

Company Westgate-Greenland

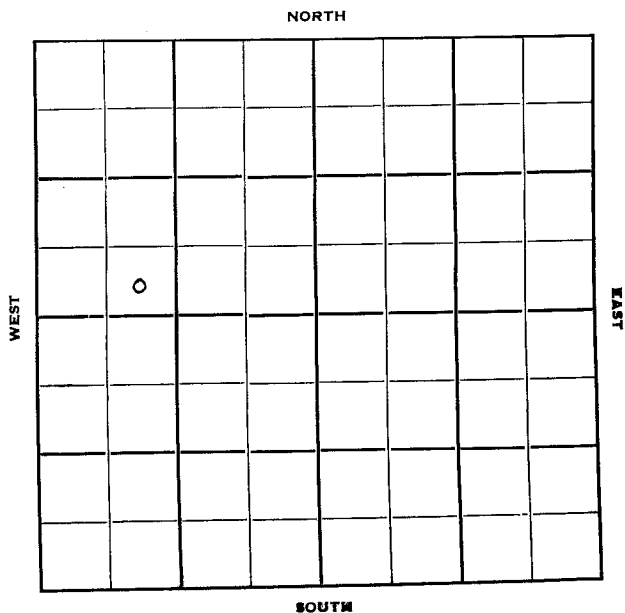

Rooks

KANSAS 18W

Sec. 17 Twp. 8 R.

Well No. #1 Banberry Farm

Westgate-Greenland Company

Jackson Contractor

Wildcat


Ft. from N. Line

330' Ft. from S. Line

Ft. from E. Line

990' Ft. from W. Line

SE SW NW

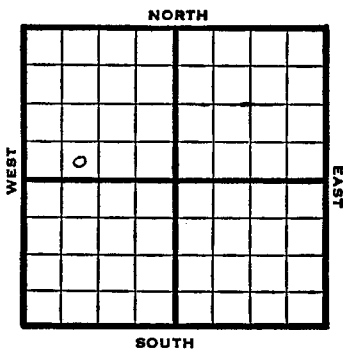


1950	Elev 1980	REPORT
6/21	Spud 6-17-50 8" @ 200' Anhy 1317' Drlg. 1840'	
10/25	8" @ 200 Anhy 1320 Lans 3147 SSO 3409 DST 3400-08 opn 1 hr rec 70' ocm 5" @ 3402 DD 3436 500 A 1000 A Sq 3411-32 DD 3438 1000 A S/2½ boph D&A	Heeb 3104 Arb 3400
	ABANDONED	

Kansas

Wildcat

Map No. _____ Sec. 17 Twp. 8 R. 18WWell No. 1 BanberryWestgate-Greenland Company_____
ST SW 1/4 Contractor

SECTION PLAT

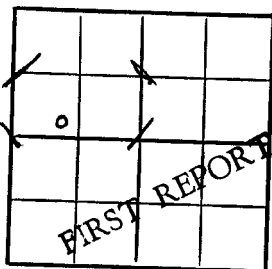_____
Ft. from N. Line330 Ft. from S. Line_____
Ft. from E. Line990 Ft. from W. LineBecks CountyPhillips farmoutGulf & Sohio acreage

RECORD

Location _____

Rig up _____

Drilling and Remarks:

Spud 6-17-50

8" @ 200

Anhy 1317

drlg. 1840

Cased _____ in., _____ ft.

Sand _____

Gas _____

Oil _____

Total Depth _____

PRODUCTION

1st 24 hrs. Nat. _____

1st 24 hrs. after shot _____

Gas _____ Cu. Ft.


Dry Hole _____

Abandoned _____

Date

JUN 21 1950 19J. E. TYRA

Scout

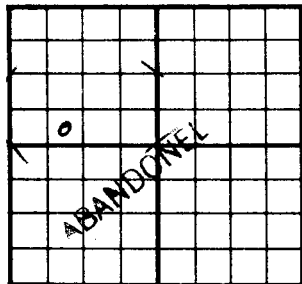County Rooks State KansasSec. 17 (Blk.
Twp.) 8 (Sur.
Rge.) 18W Map No.Operator Westgate-GreenlandWell No. 1 Farm BanberryElev. 1980 Location SE SW NW

330 Ft. From S Line NW

990 Ft. From W Line Quarter

1st. Report

Completion OCT 25 1950Remarks WildcatJackson Drlg. - Contr.Spudding Date 6-17-50

Drlg. Data

8" @ 200 Anhy 1320 Heeb. 3104 Lans. 3145

Arb. 3400 SSO 3409 DST 3400-08

open 1 hr. Rec. 70' ocm 5" @ 3402

DD 3436 500 A 1000 A Sq. 3411-32

DD 3438 1000 A S/ 2 1/2 boph

OCT 25

J. E. TYRA