


Section 17 Township 8 Range 25W

Well No. 1 Madden-Davis "B"

Company Empire Drlg.

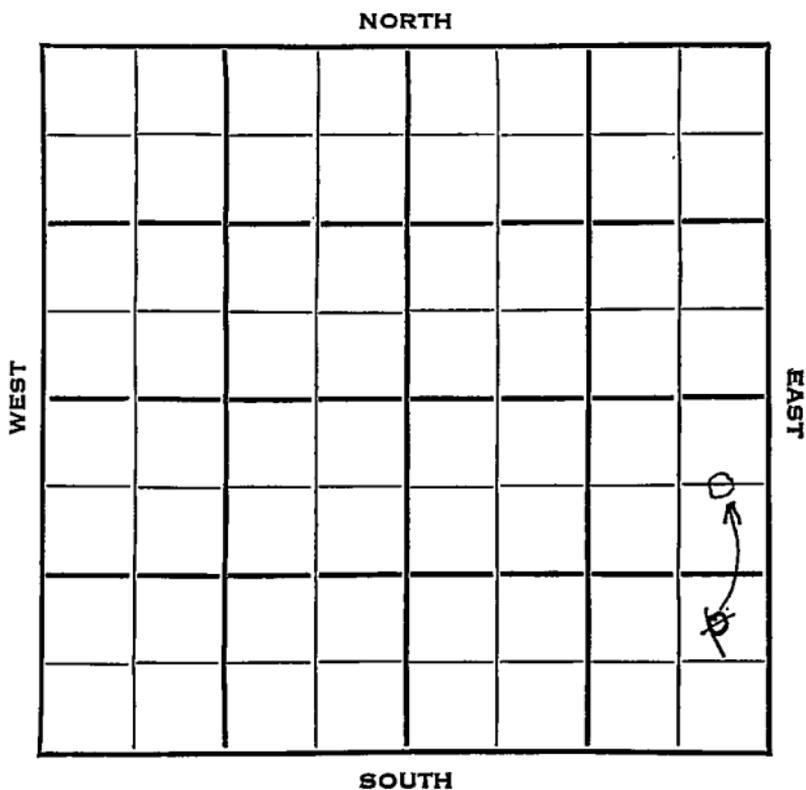

9

Graham KANSAS


SEC.	TWP.	R.
17	8	25W

WELL NO. 1 Madden-Davis "B" FARM

COMPANY Empire Drlg.

CONTRACTOR

660 Ft. from N. Line
~~990~~ Ft. from S. Line
330 Ft. from E. Line
 _____ Ft. from W. Line

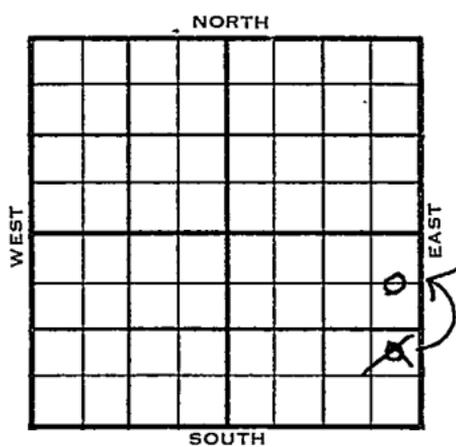

~~REL NE SE~~
~~NE SE SE~~

	ELEVATION	REPORT
1953	2346'	

12/8 Spud 12-3-53
 8" @ 199'
 Drlg. 3470'

12/16 Anhy 2045', Heeb 3595', Tor 3617', Lans 3631'
 DST 3700-3707', 1/2 hrs., 1620' gas, 540' oil, 90' hocm, 1260#
 DST 3734-50', 1 hr., 45' ocm, 200#
 DST 3766-70, 3/4 hrs., 90' oil, 40' ocm, 30' wtr, 1260' gas, 510#
 DST 3777-3805', 1/2 hrs., 1170' oil, 30' ocm, 1300#?
 RTD 3805'
 5" @ 3797'

1954
 1/6 CO 3805' 1300' oil 20 mins.
 F/7 BOPH 24 hrs. 2000 A
 F/42 BOPH 24/64" ck. 24 hrs.

1/20 Spud 12-3-53 Oil well TD 3805
 8" @ 199 Anhy 2045 Heeb 3595'
 Tor. 3617' Lans. 3631'
 DST 3700-07 open 1/2 hr rec 1620' gas, 540' oil, 90' HOCM 1260#
 DST 3734-50 open 1 hr rec 45' OCM 200#

OVER

1954
1/20

(Information continued)

DST 3761-70 open 3/4 hr, rec 90' oil
40' OCM, 30' wtr. 1260' gas, 510#
DST 3777-3805 open 1/2 hr rec 1170'
oil, 30' OCM 1300# TD 3805
5" @ 3797 CO to 3805
FU 1300' oil 20 min. F/7 BOPH
2000 A F/42 BOPH
Comp. 3000 BOPD

COMPLETED

Address

Map No. _____ Sec. 17 Twp. 8 R. 25W

Well No. 1 Madden-Davis "B"

Empire Drlg. Company

CORRECTION Contractor

C E L N E S E

SECTION PLAT

			o

660 Ft. from N. Line

_____ Ft. from S. Line

330 Ft. from E. Line

_____ Ft. from W. Line

Graham County

RECORD

Location _____

Cased _____ in., _____ ft.

Rig up _____

Sand _____

Drilling and Remarks:

Gas _____

Oil _____

Total Depth _____

Reported

NE SE SE

PRODUCTION

1st 24 hrs. Nat. _____

1st 24 hrs. after shot _____

Gas _____ Cu. Ft.

Dry Hole _____

Abandoned _____

Date

DEC 16 1953

J. G. McGEHEE

19

Scout

County Graham State Kansas

Sec. 17 (Blk. 8) (Sur. 25W) (Twp.) (Rge.) Map No.

Operator Empire Drlg.

Well No. 1 Farm Madden-Davis "B"

Elev. 2346 Location C E L N E S E

660 Ft. From N Line SE

330 Ft. From E Line Quarter

1st. Report

Completion JAN 20 1954

Remarks

Spudding Date 12-3-53

Drlg. Data Oil well TD 3805

8" @ 199 Anhy 2045 Heeb. 3595

Tor. 3617 Lans. 3631 DST 3700-07

open 1/2 hr. Rec. 1620' gas 540' oil

90' hocm 1260# DST 3734-50 open 1 hr.

Rec. 45' ocm 200# DST 3761-70

open 3/4 hr. Rec. 90' oil 40' ocm

30' wtr. 1260' gas 510# DST 3777-3805

open 1/2 hr. Rec. 1170' oil 30' ocm

1300# TD 3805 -5" @ 3797 CO to 3805

FU 1300' oil 20 min. F/ 7 boph 2000 A

F/ 42 boph Comp. 3000 bopd