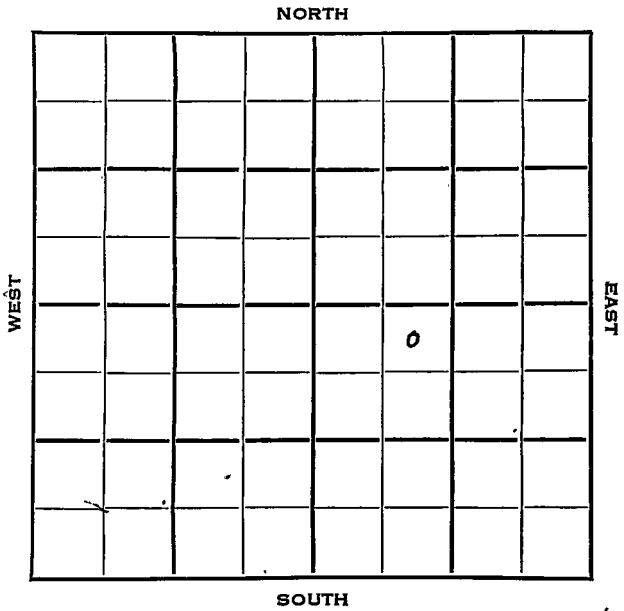


Section 17 Township 8 Range 25WWell No. #1 Madden-Davis "B"Company Texas Company

Graham

KANSAS

SEC.	TWP.	R.
17	8	25 W ✓

WELL NO.

1 Madden-Davis "B"

FARM

COMPANY

Texas Company

CONTRACTOR

Powell Drlg.

Schmeid Pool


330 Ft. from N. Line

Ft. from S. Line

Ft. from E. Line

990 Ft. from W. Line


NE NW SE

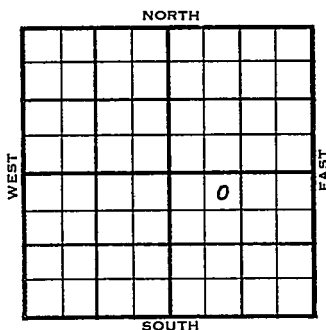

	ELEVATION	REPORT
1954	2356'	
3/17	Spud 3-15-54	
	10" @ 518	WOC
3/24	Drlg. 3605'	
3/31	Lans 3642	RTD 3865 7" @ 3864
4/7	CO 3859	13/3852-56 SSO 2000 A
	S/90 BO 3 hrs	PB 3835 10/3829-32
	70 BOPH	S/75 BOPH 3 hrs. CO 3859
	F/10 BOPH 3 hrs.	PB 3819 13/3806-10
	S/81 BOPH 500' from top.	2000 A
	F/58 BO 2 hrs.	
4/14	"	
4/21	Spud 3-15-54	
	Oil Well	
	TD 3865'	
	10" @ 518'	
	Lans 3642'	
	TD 3865'	
	7" @ 3864',	
	CO to 3859', 13/3852-56, SSO, 2000A	
	S/90 bo 3 hrs.,	
	PB 3835, 10/3829-32, 70 boph	
	S/75 boph 3 hrs., CO to 3859,	
	F/10 boph 3 hrs.	
	PB 3819, 13/3806-10, S/81 boph 2000A	
	F/58 bo 2 hrs., S/28 boph	
	omp. 3000 bopd	

COMPLETED

County Graham State Kansas
 Sec. 17 (Blk. 8 (Sur. 25W Map No.)
 (Twp.) (Rge.)
 Operator Texas Company
 Well No. 1 Farm Madden-Davis "B"
 Elev. 2356 Location NE NW SE

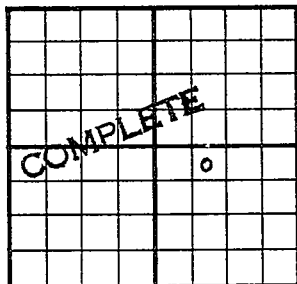

330 Ft. From N Line SE
 990 Ft. From W Line Quarter

Ist. Report

Completion APR 21 1954

Remarks Schmeid Pool

Powell Drlg. - Contr.

Spudding Date 3-15-54

Drlg. Data Oil well TD 3865

10" @ 518 Lans. 3642 TD 3865

7" @ 3864 CO to 3859 13/ 3852-56 SSO

2000 A S/ 90 bo 3 hr. PB 3835

10/ 3829-32 70 boph S/ 75 boph 3 hr.

CO to 3859 F/ 10 boph 3 hr. PB 3819

13/ 3806-10 S/ 81 boph 2000 A

F/ 58 bo 2 hr. S/ 28 boph

Comp. 3000 bopd

J. G. McGEHEE