


Section 17 Township 8 Range 25 W
 Well No. # 5 Madden-Davis "A"
 Company Texas Company

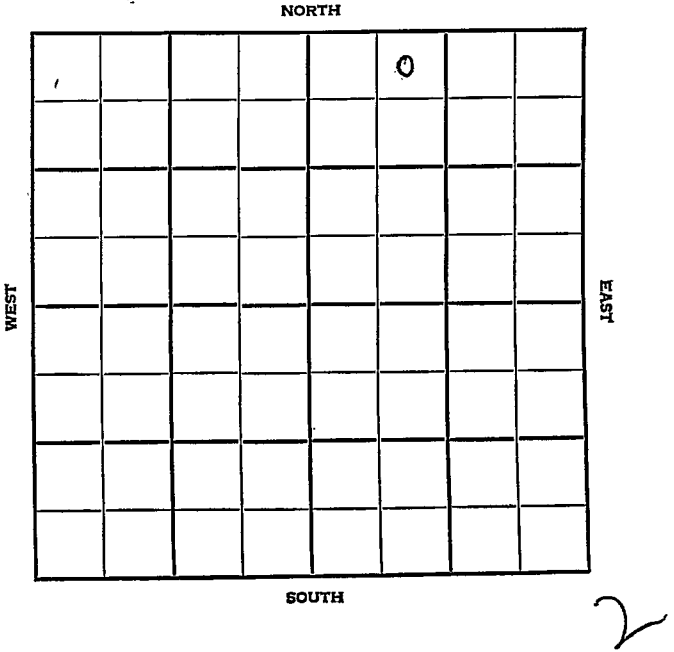

Graham

KANSAS

SEC.

TWP.

R.

17

8

25 W

WELL NO.

5 Madden-Davis "A"

FARM

COMPANY

Texas Company

CONTRACTOR

Powell

Schmeid Pool

330 Ft. from N. Line

Ft. from S. Line

Ft. from E. Line

990 Ft. from W. Line

NE NW NE

NORTH

					0		

WEST

EAST

SOUTH

ELEVATION

REPORT

1954

2402'

8/11

MTR

9/29

Spud 8-12-54

Oil Well

TD 3909'

10" @ 492'

Top 3435', Heeb 3649', Lans 3681'

TD 3908'

Schlumberger Tops: Anhy 2095', Top 3447'

Heeb 3650', Tor 3670, Lans 3679'

TD 3909'

7" @ 3906'

CO to 3880

13/ 3860-64 dry 25/ 3845-56 S/ 2½

boph 5 hr. 3000 A

S/ 49 boph 89 bwph 3 hr. P/ 287 bo
21 hr.

Comp BHB 822 bopd.

COMPLETED

County Graham State Kansas
 Sec. 17 (Blk. 8 (Sur. 25W Map No.
 (Twp.) (Rge.)
 Operator Texas Company
 Well No. 5 Farm Madden-Davis "A"
 Elev. _____ Location NE NW NE

330 Ft. From N Line NE
990 Ft. From W Line Quarter

1st. Report AUG 11 1954

Completion _____

Remarks _____

Powell - Contr.

Spudding Date _____

Drlg. Data Schmeid Pool

M I R

County	Graham			State	Kansas
Sec.	17	(Blk. Twp.)	8	(Sur. Rge.)	25W Map No.
Operator	Texas Company				
Well No.	5	Farm	Madden-Davis "A"		
Elev.	2402	Location	NE NW NE		

COMPLETE

330	Ft. From N	Line NE
990	Ft. From W	Line Quarter
1st. Report	Aug 11 1954	
Completion	SEP 29 1954	
Remarks	Powell - Contr.	
Spudding Date	8-12-54	

Drlg. Data Oil well TD 3909 Schmeid Pool
 10" @ 492 Top. 3435 Heeb. 3649
 Lans. 3681 TD 3908
 SCHLUMBERGER TOPS
 Anhy 2095 Top. 3447 Heeb. 3650
 Tor. 3670 Lans. 3679 TD 3909 7" @ 3906
 CO to 3880 13/ 3860-64 dry 25/ 3845-
 56 S/ 2 $\frac{1}{2}$ goph 5 hr. 3000 A
 S/ 49 boph 89 bwph 3 hr. P/ 287 bo ?
 21 hr. Comp. BHB 822 bopd

FABEN GILSTRAP