


DX 78-1 Graham

KANSAS

Section 17 Township 8 Range 25W

Well No. #6 Madden-Davis "A"

Company Texas Company

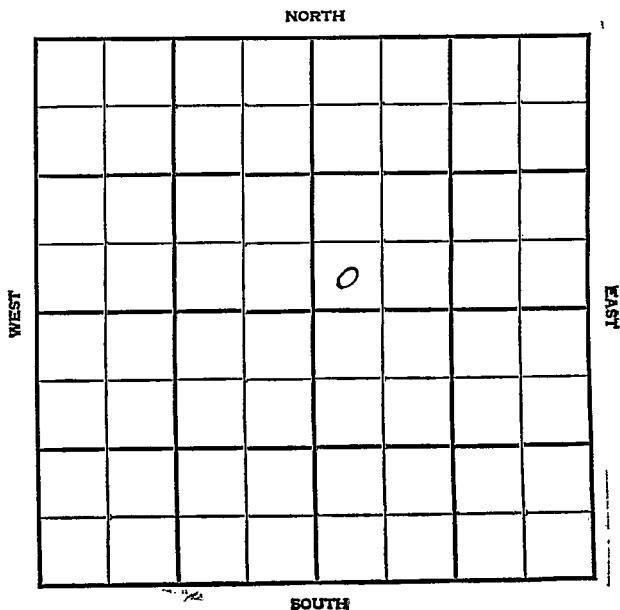

Graham

KANSAS

SEC.

TWP.

R.

17

8

25 W

WELL NO.

6 Madden-Davis "A"

FARM

COMPANY

Texas Company

CONTRACTOR

Powell

Schmeid Pool

Ft. from N. Line

330


Ft. from S. Line

Ft. from E. Line

330

Ft. from W. Line

SW SW NE

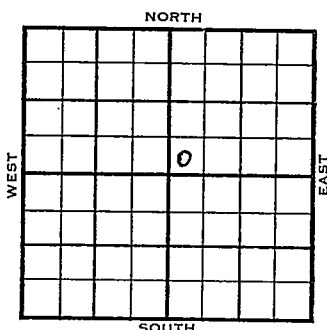

1954

ELEVATION

2363'

REPORT

10/27

Spud 10-22-54

10" @ 503

Drlg. 2430'

11/23

Spud 10-22-54 D & A TD 3879

10" @ 503 Heeb 3615 Tor. 3639

Lans. 3652

DST 3774-3879 open 1 hr rec 300' drlg.
mud, 250' SO & GCM 990# TD 3879

7" @ 3878 CO to 3862 24/3842-46

S/1/2 BWPH PB 3835 12/3821-24

500 A S/2 GO 8 GW 3 hr. 1500 A

S/2 GO 21 GWPH 12 hr. CO to 3861

S/1/2 GO 5 BWPH 6 hr. 500 A S/6 GO

2 1/2 BWPH 10 hr. PB 3785 32/3760-68

1000 A S/3 BW 1 hr. S/8 BWPH 8 hr.

D & A

ABANDONED

FABEN GILSTRAD

FABIAN GILBERT