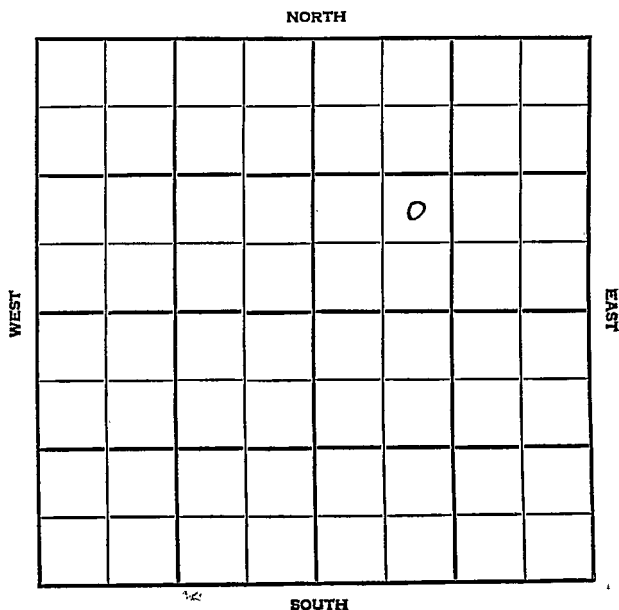


DX 78-1

Graham

KANSAS

Section 17 Township 8 Range 25WWell No. #7 Madden-Davis "A"Company Texas Company

Graham

KANSAS

SEC.	TWP.	R.
17	8	25W

WELL NO.

#7 Madden-Davis "A"

FARM

COMPANY

Texas Company

CONTRACTOR

Powell

Schmeid Pool

NORTH

Ft. from N. Line

990

Ft. from S. Line

Ft. from E. Line

990

Ft. from W. Line

NE SW NE

WEST

EAST

SOUTH

1954

ELEVATION
2368'

REPORT

11/11 RUR

12/22

Spud 11-9-54

Oil Well

TD 3873'

10" @ 500'

Top 3400' Heeb 3612' Tor 3634'

Br. Lime 3645'

TD 3873'

7" @ 3872'

Schl Tops: Top 3405', Heeb 3616',

Lans 3647' BKC 3870'

24/ 3812-18 46 boph 5 hr.


A-frac. S/ 58 boph 4 hr. P/ 107 bopd

Comp 411 bopd.

TD 3873'

COMPLETED

County Graham State Kansas
 Sec. 17 (Blk.) 8 (Sur.) 25W Map No.
 Operator Texas Company
 Well No. 7 Farm Madden-Davis "A"
 Elev. _____ Location NE SW NE

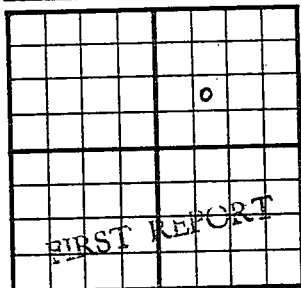


990 Ft. From S Line NE
990 Ft. From W Line Quarter
 1st. Report NOV 10 1954
 Completion _____
 Remarks Powell - Contr.
 Spudding Date _____

Drig. Data

Schmeid PoolRUR

FABEN GILSTR

County Graham State Kansas
 Sec. 17 (Blk. 8 (Sur. 25W Map No. 8)
 Operator Texas Company
 Well No. 7 Farm Madden-Davis "A"
 Elev. 2368 Location NE SWNE

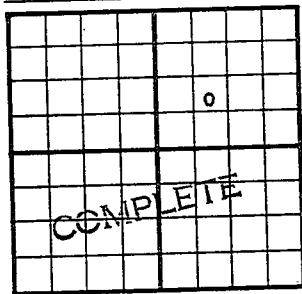

990 Ft. From S Line NE
 990 Ft. From W Line Quarter

1st. Report

Completion DEC 22 1954

Remarks Schmeid Pool

Powell - Contr.

Spudding Date 11-9-54

Drlg. Data Oil well TD 3873

10" @ 500 Top. 3400 Heeb. 3612

Tor. 3634 Br. lime 3645 TD 3873

7" @ 3872 SCHLUMBERGER TOPS:

Top. 3405 Heeb. 3616 Lans. 3647

B KC 3870 24. 3812-18 46 boph 5 hr.

A-frac S/ 58 boph 4 hr. P/ 10% bopd

Comp. 411 bopd TD 3873

FADEN GILSTRAP