


Graham KANSAS

DX 78-1

Section 17 Township 8 Range 25

Well No. 4 Madden-Davis "B"

Company Empire Drlg.

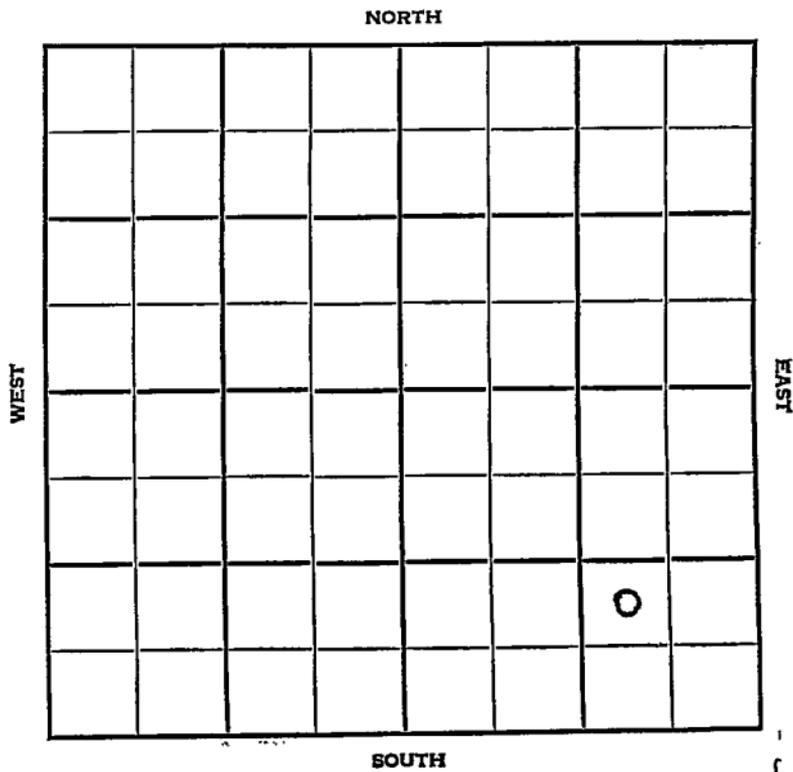

Graham KANSAS ✓


SEC.	TWP.	R.
17	8	25W

WELL NO. 4 Madden Davis "B" FARM

COMPANY Empire Drlg.

CONTRACTOR

_____ Ft. from N. Line
 990 _____ Ft. from S. Line
 990 _____ Ft. from E. Line
 _____ Ft. from W. Line

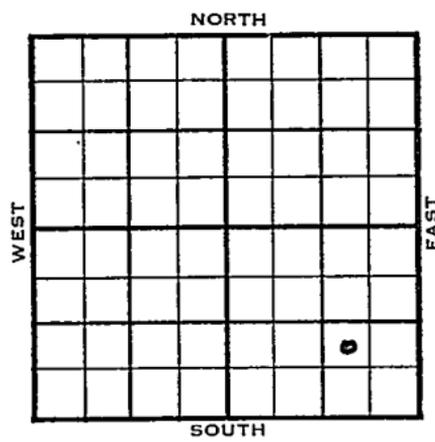

NW SE SE

1954	ELEVATION 2349'	REPORT
------	--------------------	--------

6/30 Spudding 6-27-54
 8" @ 171
 WOC

7/7 KC 3636'
 Drlg. 3730'

7/21 RTD 3808' 5" @ 3798 CO 3808
 40 BOPH

7/28 Spud 6-27-54 Oil well TD 3808
 8" @ 171 Heeb 3599 Tor. 3619
 KC 3636 TD 3808 5" @ 3798
 CO to 3808 3000 A 40 BOPH
 Comp. 3000 BOPD

COMPLETED

County **Graham** State **Kansas**

Sec. **17** (Blk. Twp.) **8** (Sur. Rge.) **25W** Map No.

Operator **Empire Drlg.**

Well No. **4** Farm **Ladden Davis "B"**

Elev. Location **NW SE SE**

FIRST REPORT

o

990 Ft. From **S** Line **SE**

990 Ft. From **E** Line Quarter

1st. Report **JUN 30 1954**

Completion

Remarks

Spudding Date **6-27-54**

Drlg. Data

8" @ 171 WOC

J. G. MCGEE


County Graham State Kansas

Sec. 17 (Blk. 8 (Sur. 25W Map No. 8)
(Twp.) (Rge.)

Operator Empire Drlg.

Well No. 4 Farm Madden-Davis "B"

Elev. 2349 Location NW SE SE

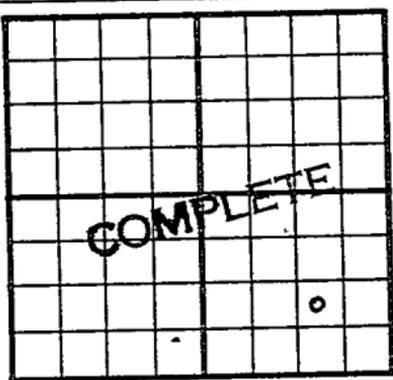

990 Ft. From S Line SE

990 Ft. From E Line Quarter

1st. Report _____

Completion JUL 28 1954

Remarks _____

Spudding Date 6-27-54

Drlg. Data Oil well TD 3808

8" @ 171 Heeb. 3599 Tor. 3619

KC 3636 TD 3808 5" @ 3798 CO to 3808

3000 A 40 boph Comp. 3000 bopd