

Graham

Section 17 Township 8 Range 22WWell No. 1 CulpCompany Empire Drlg.

NORTH

WEST

			0				

EAST

SOUTH

Graham


KANSAS ✓

Sec. 17 Twp. 8 R. 22 WWell No. # 1 Culp FarmEmpire Drlg. & Harry Gore Company

Contractor

 Ft. from N. Line330 Ft. from S. Line330 Ft. from E. Line Ft. from W. Line

SE SE NW

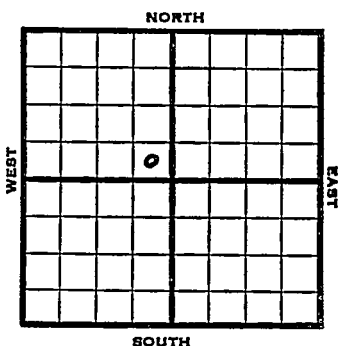

1952

REPORT

12/10 Location

12/11 "

12/18 Ø2735

12/23 Spud 12-12-52

D & A TD 3790' 8" @ 190

Heeb 3320' Tor. 3342' KC 3357'


B KC 3570' Cong. 3708' Arb. 3754'

TD 3790' D & A

ABANDONED

J. G. McGEHEE

County Graham State Kansas
 Sec. 17 (Blk. 8 (Sur. 22W Map No.)
 (Twp.) (Rge.)
 Operator Empire Drlg. & Harry Gore
 Well No. 1 Farm Culp
 Elev. 2095 Location SE SE NW

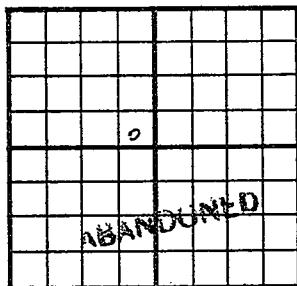

330 Ft. From S Line NW
330 Ft. From E Line Quarter

1st. Report

Completion DEC 23 1952

Remarks

Spudding Date 12-12-52

Drlg. Data D & A TD 3790

8" @ 190 Heeb. 3320 Tor. 3342

KC. 3357 B KC 3570 Cong. 3708

Arb. 3754 TD 3790

D & A

J. G. McGEHEE