


Section 17 Township 8 Range 22 W

Well No. #2 Hickman

Company Empire Drlg.

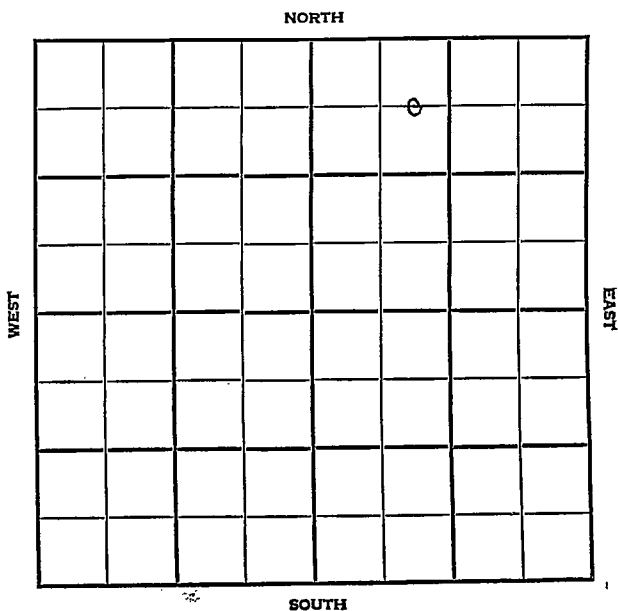

Graham

KANSAS

SEC. 17	TWP. 8	R. 22W	22W
------------	-----------	-----------	-----

WELL NO.

#2 Hickman

COMPANY

FARM

Empire Drlg.

CONTRACTOR

Schneblg


_____ Ft. from N. Line

_____ Ft. from S. Line

_____ Ft. from E. Line

_____ Ft. from W. Line

C E $\frac{1}{2}$ NW NE

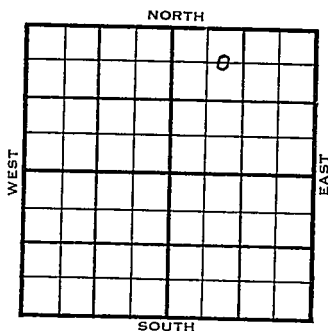

	ELEVATION	REPORT
1955	2100 KB	

7/27

Comm 4-26-55
 8" @176 DST 3480-3510 open 1 hr. Rec.
 390' msw 980/20" DST 3510-25 open 1
 hr. 2400' GIP Rec. 270' oil 90' hocm
 160/20" 5 $\frac{1}{2}$ " @3519 DD 3525 1 $\frac{1}{2}$ Boph 300A
 S/10 boph.
 Anh: 1721, H. 3313, 1213; Tr. 3335, 1235;
 L. 3348, 1248; TD 3525.

FIRST REPORT

+

COMPLETED

County Graham Elev. 2100 KB
 Sec. 17 Twp. 8 Rgs. 22W
 Company Empire Drlg.
 Farm Name Hickman No. 2

Co.

TOPS	DEPTH	LOG	DATUM	Loc. in Sec.
Anh.	1721			C E $\frac{1}{2}$ NW NE
Tr.	3335		1235	
Dg.				Geol.
Bl.				
L.	3348		1248	Contr.
K.C.				
B.K.C.				Pool
Ce.				
C.				Schnebly
M.				
M.				<div style="border: 1px dashed black; padding: 5px; text-align: center;"> <p>REPORT COMPLETE</p> </div>
K.				
Mz.				
Ma.				
V.				
S.				
S.				
A.				
R.				
PE.				
G.				
TD.	3525			

Sec.

No.

Sec.

T.

R.

Date Comm. 4-26-55 JUL 27 1955
8" @ 176 DST 3480-3510 open 1 hr.
Rec. 390' msw 980/20" DST 3510-25
open 1 hr. 2400' GIP Rec. 270' oil
90' hocm 160/20" 5 $\frac{1}{2}$ " @ 3519
DD 3525 1 $\frac{1}{2}$ boph 300 A S/ 10 boph
Comp. 30 bopd

