

AFFIDAVIT AND COMPLETION FORM

State Geological Survey

WICHITA BRANCH ACO-1

78-8-18W

This form must be filed in triplicate with the Kansas Corporation Commission, 200 Colorado Derby Building, Wichita, Kansas 67202, within five days after the completion of the well, regardless of how the well was completed. Circle one: Oil, gas, dry, SWD, OWWO, injection. Please type. Complete ALL sections. Applications must be filed for dual completion, commingling, salt water disposal and injection. Attach wireline logs (i.e. electrical log, sonic log, gamma ray neutron log, etc.) KCC#-(316) 263-3238.

OPERATOR Frontier Oil Company

API NO. 15-163-21,548

ADDRESS 1720 KSB Building
Wichita, Kansas 67202

COUNTY Rooks

FIELD Hobart Ext

**CONTACT PERSON Terry Piesker
PHONE 913-483-5348

LEASE Steeple's "B"

PROD. FORMATION n/a

PURCHASER n/a

WELL NO. 1

ADDRESS _____

WELL LOCATION SE/4 NE/4 SW/4

1650 Ft. from South Line and

2310 Ft. from West Line of

the SW/4 SEC. 28 TWP. 8S RGE. 18W

DRILLING CONTRACTOR Red Tiger Drilling Company

ADDRESS 1720 KSB Building
Wichita, Kansas 67202

PLUGGING CONTRACTOR Red Tiger Drilling Company

ADDRESS 1720 KSB Building, Wichita, Kansas 67202


TOTAL DEPTH 3,445' PBDT _____

SPUD DATE 1/15/82 DATE COMPLETED 1/21/82

ELEV: GR _____ DF _____ KB 2,000'

DRILLED WITH (~~BARRE~~) (ROTARY) (~~ATK~~) TOOLS

Report of all strings set — surface, intermediate, production, etc. (New)/(~~USED~~) casing.

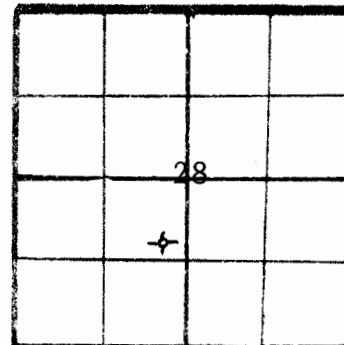

WELL PLAT
(Quarter) or (Full) Section - Please indicate.

KCC
KGS

MISC. _____

Purpose of string	Size hole drilled	Size casing set (in O.D.)	Weight lbs/ft.	Setting depth	Type cement	Sacks	Type and percent additives
Surface	12 1/4"	8 5/8"	20#	339'	Common	190 sx	3% C.C., 2% Gel

LINER RECORD

Top, ft.	Bottom, ft.	Sacks cement

PERFORATION RECORD

Shots per ft.	Size & type	Depth interval

TUBING RECORD

Size	Setting depth	Pecker set at

ACID, FRACTURE, SHOT, CEMENT SQUEEZE RECORD

Amount and kind of material used

RECEIVED

STATE CORPORATION COMMISSION

MAR 15 1982

CONSERVATION DIVISION
WICHITA, KANSAS

Name of lowest fresh water producing stratum Unknown Depth 100'
Estimated height of cement behind pipe 333'

WELL LOG

Show all important zones of porosity and contents thereof; cored intervals, and all drill-stem tests, including depth interval tested, cushion used, time tool open, flowing and shut-in pressures, and recoveries.

SHOW GEOLOGICAL MARKERS, LOGS RUN, OR OTHER DESCRIPTIVE INFORMATION.

FORMATION DESCRIPTION, CONTENTS, ETC.	TOP	BOTTOM	NAME	DEPTH
Clay & Shale	0	349		<u>28-8-18w</u>
Shale	349	900		
Sand	900	1135		
Red Bed & Shale	1135	1420		
Anhydrite	1420	1464		
Shale	1464	2871		
Shale & Lime	2871	3118		
Lime	3118	3445		
RTD		3445		

USE ADDITIONAL SHEETS, IF NECESSARY, TO COMPLETE WELL RECORD.

AFFIDAVIT

STATE OF Kansas, COUNTY OF Sedgwick SS,

George A. Angle OF LAWFUL AGE, BEING FIRST DULY SWORN UPON HIS OATH, DEPOSES AND SAYS:

THAT HE IS Owner ~~FOR~~ OF Frontier Oil Company
OPERATOR OF THE Steeple's "B" LEASE, AND IS DULY AUTHORIZED TO MAKE THIS
AFFIDAVIT FOR AND ON BEHALF OF SAID OPERATOR, THAT WELL NO. 1 ON SAID LEASE HAS
BEEN COMPLETED AS OF THE 21st DAY OF January 19 82, AND THAT ALL
INFORMATION ENTERED HEREIN WITH RESPECT TO SAID WELL IS TRUE AND CORRECT.