

O.W.W.O.

FORM 51 25M 3-49 PETROL

KANSAS

Rooks

Section 18 Township 8 Range 18-W

Well No. #1 R. Sweet

Company Westgate-Greenland

NORTH

WEST

							O

EAST

SOUTH

O.W.W.O. Rooks

KANSAS

Sec. 18 Twp. 8 R. 18W

Well No. #1 R. Sweet Farm

Westgate-Greenland Company

Jackson Drlg. - Contr. Contractor

Wildcat


330' Ft. from N. Line

Ft. from S. Line

330' Ft. from E. Line

Ft. from W. Line

NE NE SE

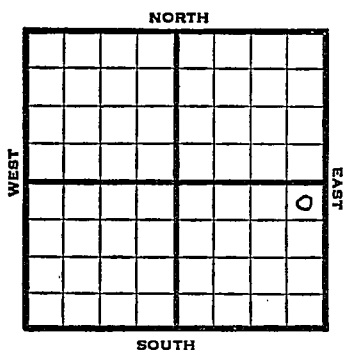

1950 Elev. 1995' REPORT

9/6 Spud 9-3-50

8" @ 169'

Drlg. 200'

10/18 Spud 9-3-50

D&A TD 3489'

8" @ 169'

Anhy 1385' Lans. 3167'

Arb. 3421'

DST 3423-29 opn 1 hr

Rec. 60' SOCM

TD 3433'

5" @ 3423

B/12 GOPH 2000 A

S/1½ BOPH DD 3489' No inc.

D&A

ABANDONED

1951 O.W.W.O.

10/10 Arb. 3421-29' TD

5" @ 3423' CO to 3433' TD

2000 A S/1½ BOPH TD 3489'

PB 3462'

P/10 BOPD

OVER

~~1951~~
10/17

Arb. 3421-29TD

5" @ 3423

GO to 3433


2000 A S/1½ boph

DD 3489 PB 3462

Comp. 10 bopd

COMPLETED

County Rooks State Kansas
 Sec. 18 (Blk. Twp.) 8 (Sur. Rge.) 18W Map No.
 Operator Westgate-Greenland
 Well No. 1 Farm P. Sweet
 Elev. _____ Location NE NE SE

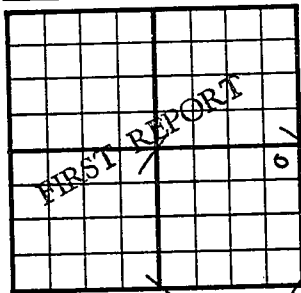

330 Ft. From N Line SE
330 Ft. From E Line Quarter
 Ist. Report SEP 6 1950
 Completion _____
 Remarks _____
 Spudding Date 9-3-50

Drlg. Data


8" @ 169 drlg. 200

J. E. TYRA

County _____ Rooks _____ State **Kansas**Sec. 18 (Blk.) 8 (Sur.) 18W Map No. _____
(Twp.) (Rge.)Operator Westgate-Greenland

Well No. 1 Farm R. Sweet

Elev. 1995 Location NE NE SE

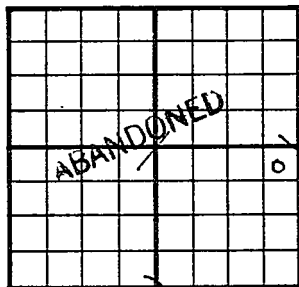

330 Ft. From N Line SE

330 Ft. From E Line Quarter

1st. Report _____

Completion **OCT 18 1950**Remarks WildcatJackson Drlg. - Contr.

Spudding Date 9-3-50

Drlg. Data D & A TD 3489

8" @ 169 Anhy 1385 Lns. 3167 Arb. 3421

DST 3423-29 open 1 hr. Rec. 60' soem

TD 3433 5" @ 3423 B/ 12 goph 2000 A

S/ $1\frac{1}{2}$ boph DD 3489 no inc.

D & A

J. E. TYRA

County **Rooks** State **Kansas**

Sec. **18** (Blk. Twp.) **8** (Sur. Rge.) **18W** Map No.

Operator Westgate Greenland

Well No. 1 Farm Sweet

Elev.	Location	NE	NE	SE
-------	----------	----	----	----

FIRST REPORT

330 Ft. From N Line SE

330	Ft. From	E	Line	Quarter
-----	----------	---	------	---------

1st. Report **OCT 10 1951**

Completion

Remarks ^{WAS-} Reported D + A.

Spudding Date 07/11/0

Wildcat

Drig. Data

Arb 3421-29 T.D. 5ⁿ @ 3423 CO to 3433 T.D.

2000A S/1 $\frac{1}{2}$ Boph T.D. 3489 PB 3462 P 10

Bopd. ~~was destroyed~~

J. E. TYRA

J. E. TYRA