KANSAS Rooks


FORM 51 10M 8-47

Section 18 Township 8 Range 16-W

Well No. #1 Chesney

Company Crow Drlg.

Wildcat

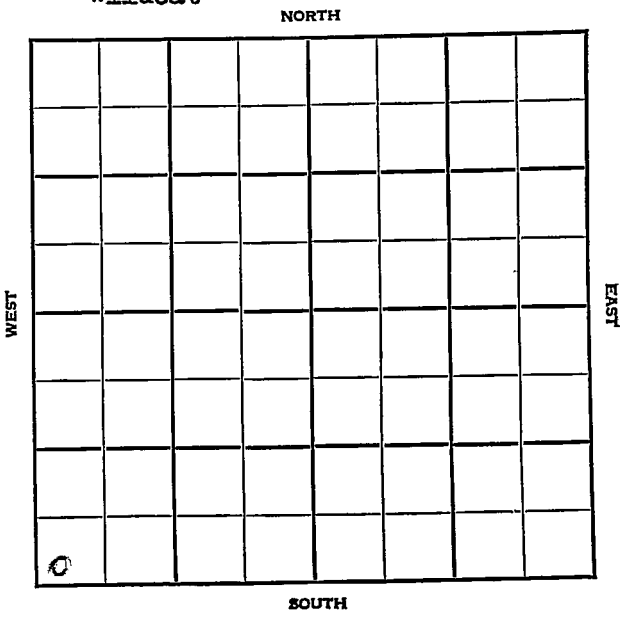

FORM 252-A
5M 4-48 PETROL

KANSAS


Rooks

Sec. 18 Twp. 8 R. 16W

Well No. #1 Chesney Farm

Crow Drlg. Company

Wildcat

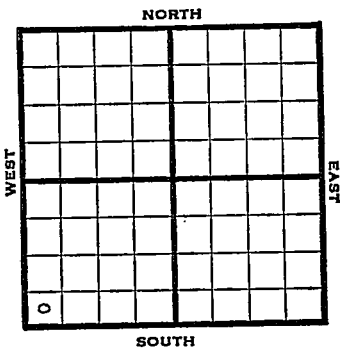

_____ Ft. from N. Line

330' Ft. from S. Line

_____ Ft. from E. Line

330' Ft. from W. Line

SW/C

REPORT

1948	Eli 1867'
6/16	Location
6/23	8"@ 163 Drlg 1565'
6/29	Drlg. 3018'
7/14	TD 3365' Arb. 3335' 4½"@ 3230' Aband.

ABANDONED

Form 26—200 Bks.—1-48—Palace

Wildcat

Kansas

Map No. _____ Sec. 18 Twp. 8 R. 16W


Well No. 1 Chesney

Crow Drlg. Company

FIRST REPORT Contractor

SW/C

SECTION PLAT

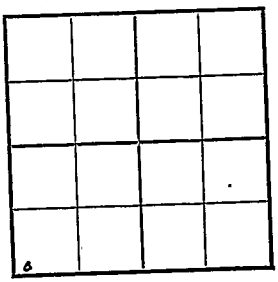

_____ Ft. from N. Line

330 Ft. from S. Line

_____ Ft. from E. Line

330 Ft. from W. Line

Rooks County

Location X

Rig up

Drilling and Remarks:

RECORD

Cased _____ in., _____ ft.

Sand

Gas

Oil

Total Depth

PRODUCTION

1st 24 hrs. Nat.

1st 24 hrs. after shot

Gas _____ Cu. Ft.

Dry Hole

Abandoned

Date

JUN 16 1948 19____ S. J. LEWIS Scout

Form 26—200 Bks.—1-48—Palace

Kansas

Wildcat

Map No. 64 Sec. 18 Twp. 8 R. 16W

Well No. 1 Chesney


Crown Drlg. Company

ABANDONED Contractor

E 1/2 NE

SW/C

SECTION PLAT

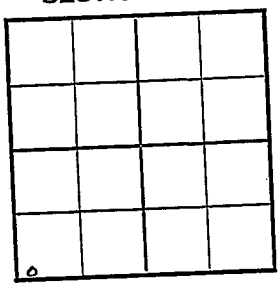

____ Ft. from N. Line

330 Ft. from S. Line

____ Ft. from E. Line

330 Ft. from W. Line

Rooks County

Location

Rig up

Drilling and Remarks:

Cir 3335

Ft 3230

RECORD

Cased ____ in., ____ ft.

Sand

Gas

Oil

Total Depth 3365

PRODUCTION

1st 24 hrs. Nat.

1st 24 hrs. after shot

Gas ____ Cu. Ft.

Dry Hole

Abandoned

Date

JUL 14 1948 19____ S. J. LEWIS Scout