

Wildcat

NORTH

WEST

EAST

SOUTH

Rooks KANSAS

Sec. 18 Twp. 8 R. 18W

Well No. #1 Bouchey Farm

S. Murphy et al Company

Wildcat


330' Ft. from N. Line

 Ft. from S. Line

 Ft. from E. Line

990' Ft. from W. Line

NE NW NW

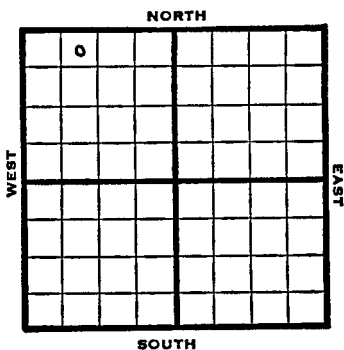

1949

Elev. 2008' REPORT

6/29 Location

7/6 RUR

7/12 8" @ 107'
Drlg 2847'

7/20 Lans. 3192'
Cong. 3481'
Arb. 3493'
TD 3494'

ABANDONED

Map No. _____ Sec. 18 Twp. 8 R. 18W

Well No. 1 Bouchey

S. Murphy et al. Company

NE NW NW Contractor


FIRST REPORT
SECTION PLAT

330 Ft. from N. Line

Ft. from S. Line

Ft. from E. Line

990 Ft. from W. Line

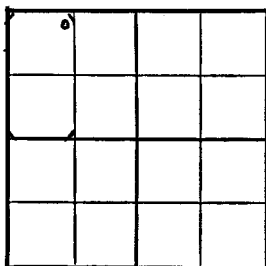

Rooks County

Location X

Rig up

Drilling and Remarks:

RECORD

Cased in., ft.

Sand

Gas

Oil

Total Depth

PRODUCTION

1st 24 hrs. Nat.

1st 24 hrs. after shot

Gas Cu. Ft.

Dry Hole

Abandoned

Date

JUN 29 1919

S. J. LEWIS Scout

Kansas

Wildcat

Map No. K64 Sec. 18 Twp. 8 R. 18WWell No. 1 BoucheyS. Murphy et al.

Company

ABANDONED

Contractor

NE NW NW

E1, 2008**SECTION PLAT**330 Ft. from N. Line

Ft. from S. Line

Ft. from E. Line

990 Ft. from W. Line

6			

Rooks County

Location

Rig up

Drilling and Remarks:

Lease 3192Comp 3491Pl 18493**RECORD**

Cased _____ in. _____ ft.

Sand _____

Gas _____

Oil _____

Total Depth 3494**PRODUCTION**1st 24 hrs. None

1st 24 hrs. after shot _____

Gas _____ Cu. Ft.

Dry Hole _____

Abandoned _____

Date

JUL 20 194919S. J. LEWIS Scout