


Section 18 Township 8 Range 21 W

Well No. #1 Calhoun

Company Taxman Oil

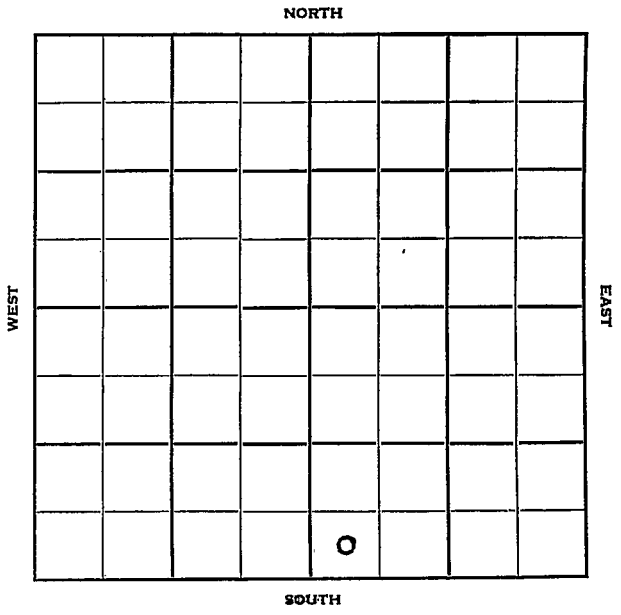

Graham

KANSAS

Sec. 18 Twp. 8 R. 21W

Well No. #1 Calhoun Farm

Taxman Oil Company

Anschutz Drlg. - Contr. Contractor
Wildcat


Ft. from N. Line

330' Ft. from S. Line

Ft. from E. Line

330' Ft. from W. Line

SW SW SE

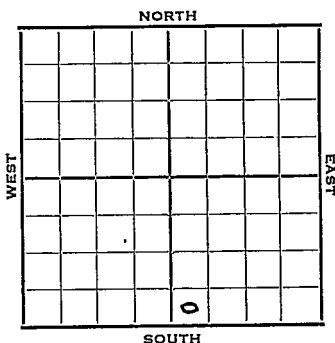

1952 Elev. 2056' REPORT

3/12 Spud 3-9-52
Drlg.

3/19 Spud 3-9-52
D&A TD 3660
8" @ 193'
Anhy 1645
Tor. 3276
Cong. 3608
TD 3660
D&A

Heeb. 3254
Lans. 3294
Arb. 3644

ABANDONED

