

KANSAS


FORM 51 5M 1-42 PETROL

Graham

Section 18 Township 8 Range 25 WW

Well No. #1 C. H. Hazen

Company Mid-Continent Pet. Co.

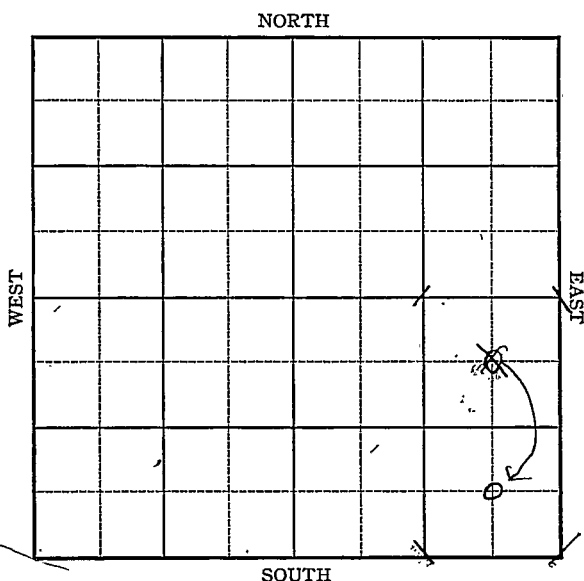

16

Sec. 18 Twp. 8 R. 25-W

Well No. #1 G. H. Hazen Farm

Mid-Continent Petr. Corp. & Company


National Petr. Co.

~~660~~ Ft. from N. Line

660 Ft. from S. Line

660 Ft. from E. Line

Ft. from W. Line

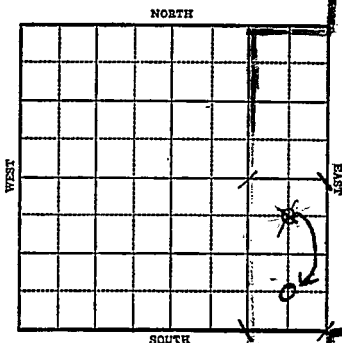

1943 Elev. 2372 R E P O R T

8/11 Location

8/16 Cellar dug 8-15-43
Moving in material

8/18 " "

8/19 " "

8/25 Drlg. 2340

8/25 Drlg. 2570 in Red Rock Anhy 2098

8/25 10" - 311'

Spudded Aug. 19, 1943

Drlg. 2590'

8/28 Drlg. 2815

8/31 Drlg. 3365

Top Topeka 3320

9/1 Top Lansing 3567

Drlg. 3642

No shows yet.

Have 46' to go to get Pay Zone

Running 26' lower on Lansing than Union Oil of California #1 Pratt in NW corner NE/4 SW/4 23-8S-26W Discovery well (Mr. Moore)

Running 15' lower on Lansing than Union Oil of California #2 Pratt in NE SE NW 23-8S-26W a Producer. Sheridan County (Mr. Moore)

OVER

1943

9/2 Cored 3685-3703 - Recovered 11 feet
Top 2 feet shale
Next 9 feet lime with shale partings
Middle 2 feet in the above 9 feet was
porous - no shows
Drlg. 3705 (Tel)

9/3 Base Kansas City ~~3790~~ 3797
Stain 3715-17
Drlg. 3800

9/3 Slight stain 3715-17
Base Kansas City 3797
Drilling 3801 (Telegram)

9/7 Top Arbuckle 4209 No shows.
Drlg. 4238' (Telephone)

Running 32 feet lower than Union Oil,
#1 Pratt Producer in NW SW 23-8S-26W.

9/10 Drlg. 4294' No shows.

Red

9/13 Cored 4440-57' Rec. 8'

2' green shale

3' cherty lime

3' porous lime

No shows

T.D. 4457'

Running Schlumberger. (Tel)

9/15 T.D. 4457 - plugging.

Texas Co

4-3590

Marker 3805

Detail 4215

Miss 4240

OVER

1943

9/15

Topeka-3313

Lans 3687

BKC 3902

Miss 4232

Viola 4330

Simp. 4435

Arb 4444

T.D. 4457&

4444


2372

2072

ABANDONED

KANSASMap No. 67 Sec. 18 Twp. 8 R. 25WWell No. 1 G. H. HazenMid-Continent Petr. & CompanyNational Petr.**FIRST REPORT**

Contractor

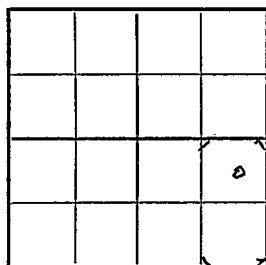C NE SE**SECTION PLAT**660 Ft. from N. Line Ft. from S. Line660 Ft. from E. Line Ft. from W. Line**WILDCAT**Location XXXRig up

Drilling and Remarks:

RECORDCased in., ft.Sand Gas Oil Total Depth **PRODUCTION**1st 24 hrs. Nat. 1st 24 hrs. after shot Gas Cu. Ft.Dry Hole Abandoned

Date

AUG 11 1943 19S. J. LEWIS

Scout

Map No. 67 Sec. 18 Twp. 8 R. 25W

Well No. 1 G. H. Hazen


Mid-Continent Pet. & National Pet. Company

CORRECTION

Contractor

C. SE SE

SECTION PLAT

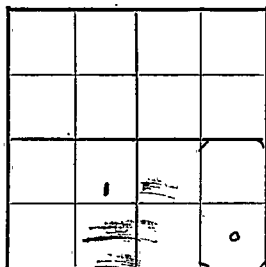

Ft. from N. Line

660

Ft. from S. Line

660

Ft. from E. Line

Ft. from W. Line

WILDCAT

RECORD

Location

Cased _____ in., _____ ft.

Rig up

Sand _____

Drilling and Remarks:

Gas _____

Oil _____

Reported C NE SE

Total Depth _____

This would put
it in the
Solomon River

PRODUCTION

1st 24 hrs. Nat. _____

1st 24 hrs. after shot _____

Gas _____ Cu. Ft.

Dry Hole _____

Abandoned _____

Date

AUG 1 8 1943 19

S. J. LEWIS Scout

KANSASMap No. 27 Sec. 18 Twp. 8 R. 2Well No. 1 G. H. HazenMid-Continent Petr. & Com
National Petr.ABANDONED Contra

C SE SE

SECTION PLAT

 Ft. from N. Line660 Ft. from S. Line660 Ft. from E. Line Ft. from W. Line

Wildcat

Location Rig up

Drilling and Remarks:

*Tofeka 3313**Liane 3687**BHC 3902**Mus 4332**Vida 4330**Sage 4435**BeX 4444*

RECORD

Cased in., ft.Sand Gas Oil Total Depth 4457

PRODUCTION

1st 24 hrs. Nat. 1st 24 hrs. after shot Gas Cu. Ft.Dry Hole Abandoned

Date

SEP 15 1943

19

S. J. LEWIS


Scout

LOCATION NOTICE

TULSA, OKLA., August 14, 19 43

WELL NO. One (1) ON G. H. Mason FARM

WILL BE AS FOLLOWS:

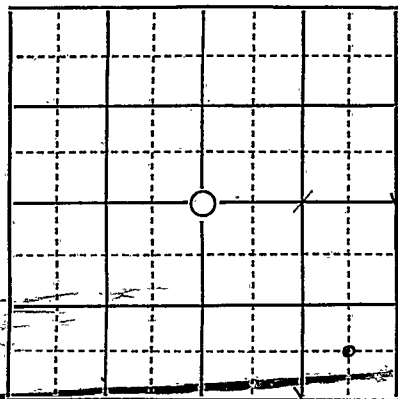

..... FEET FROM NORTH LINE
 550 FEET FROM EAST LINE
 550 FEET FROM SOUTH LINE
 FEET FROM WEST LINE

IN 1/2 33/4 SEC. 18 TWP. 28 RANGE 25N


REMARKS: Mid-Continent Pet. Corp. 3/8 int., Operators: F. H. Lindsey 3/8 int.;

The Texas Co. 1/8 override. See Agreement.

Lloyd Snyder, District Supt.

G. H. McManahan, Dist. Foreman

SIGNED.....

A. E. PIERCE

COPIES TO

DISTRICT SUPT.
 ACCOUNTING DEPT.
 RENTAL DEPT.
 SCOUTING DEPT. ✓
 ENGINEERING DEPT.
 LEGAL DEPT.
 LEASE INVENTORY
 CLAIM DEPT.
 TAX DEPT.
 GEOLOGICAL DEPT.
 FILE
 PURCHASING DEPT.

H. G. Warnock
J. W. Linchan

*Corrected from summer
 was let included
 C-28-28*