
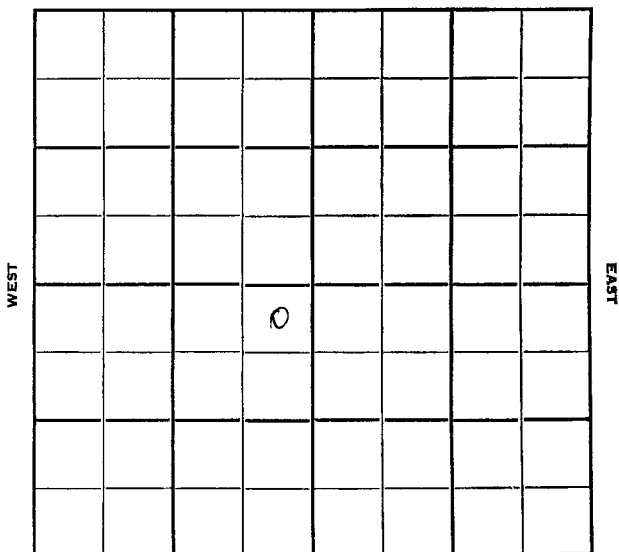


Section 9 Township 8 Range 19 WWell No. # 1 SchneiderCompany Deep Rock

NORTH

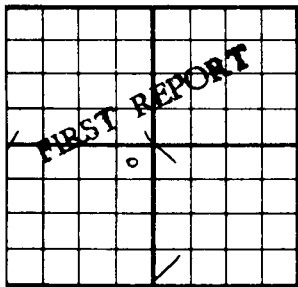

SOUTH

County **Rooks** State **Kansas**Sec. **9** (Bik. Twp.) **8** (Sur. Rge) **19W** Map No.Operator **Deep Rock**Well No. **1** Farm **Schneider**Elev. Location **NE NE SW****330** Ft. From **N** Line **SW****330** Ft. From **E** Line Quarter1st. Report **NE NE SW**


Completion

Remarks

Creekmore Drlg. - Contr.

Spudding Date

Drlg. Data **Wildcat****Collar and pits****J. E. TYRA**

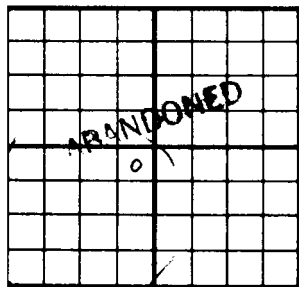County _____ Rocks _____ State **Kansas**Sec. **9** (Blk.) **8** (Sur.) **19W** Map No. _____
(Twp.)Operator **Deep Rock**Well No. **1** Farm **Schneider**Elev. **1947** Location **NE NE SW**330 Ft. From **N** Line **SW**330 Ft. From **E** Line **Quarter**

1st. Report _____

Completion **AUG 8 1951**Remarks **Wildcat**

Creekmore Drlg. - Contr

Spudding Date **7-26-51**Drlg. Data **D & A** **TD 3475****8" @ 260** **Lans. 3153** **DST 3310-60****open $\frac{1}{2}$ hr.** **Rec. 10' socm** **Arb. 3423****DST 3412-33** **open $\frac{1}{2}$ hr.** **Rec. 40' mud****DST 3435-75** **open 1 hr.** **Rec. 235' mud****& water** **TD 3475****D & A****J. E. TYRA**

Rooks

KANSAS
19 W

9

8

Sec. _____ Twp. _____ R. _____

1 Schneider

Well No. _____ Farm _____

Deep Rock

Company _____

Creekmore Drlg.

Contractor _____

Wildcat

330

Ft. from N. Line


Ft. from S. Line

330

Ft. from E. Line

Ft. from W. Line

NE NE SW

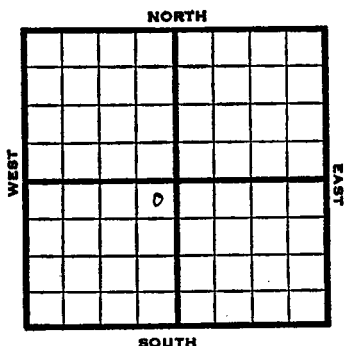

1951

Elev. 1947 REPORT

7/11

Cellar & pits

8/8

Spud 7-26-51

D&A TD 3475

8" @ 260

Lans. 3153

DST 3310-60 opn $\frac{1}{2}$ hr

Rec. 10' soom

^Arb. 3423

DST 3412-33 opn $\frac{1}{2}$ hr Rec. 40' mud

DST 3435-75 opn 1 hr Rec. 235' mud

& wtr TD 3475' D&A

ABANDONED