FORM 51 10M 7-48 PETROL

Rooks


KANSAS

Section 19 Township 8 Range 19W

Well No. 1 Campbell

Company Sam Pack et al

Wildcat

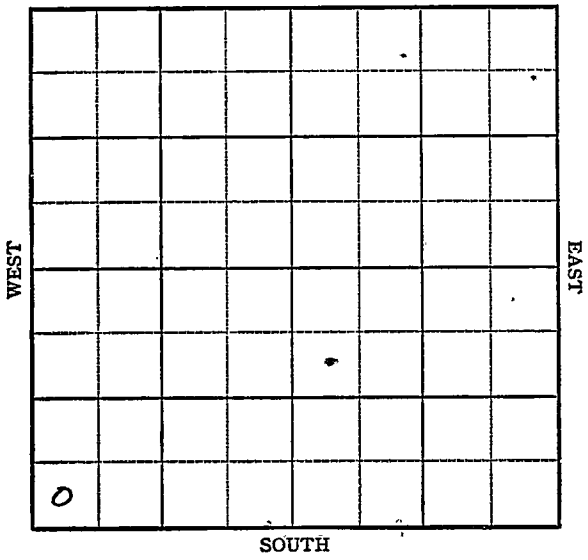

FORM 252-A
5M 10-48 PETROL

KANSAS Rooks ✓

Sec. 19 Twp. 8 R. 19W

Well No. #1 Campbell Farm

Sam Pack et al Company

Wildcat


Ft. from N. Line

330' Ft. from S. Line

Ft. from E. Line

330' Ft. from W. Line

SW/C

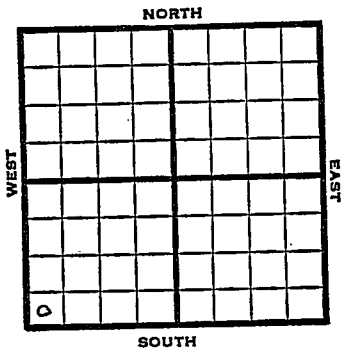

1948	Elev 2037' REPORT
12/29	RUR
1949 1/12	TD 3537' Lansing 3252' Cong 3512' Arb 3516' Aband. ABANDONED

Form 26 200 Bks. 9-48 Petrol

Kansas

Wildcat

Map No. _____ Sec. 19 Twp. 8 R. 19W


Well No. 1 Campbell

Sam Pack etal. Company

FIRST REPORT Contractor

SW/C

SECTION PLAT

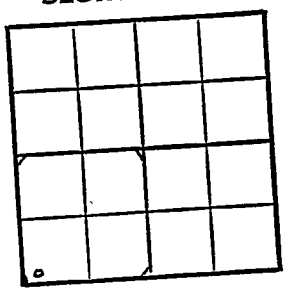

_____ Ft. from N. Line

330 Ft. from S. Line

_____ Ft. from E. Line

330 Ft. from W. Line

Rooks County

Location _____

Rig up _____

Drilling and Remarks:

R U R

RECORD

Cased _____ in., _____ ft.

Sand _____

Gas _____

Oil _____

Total Depth _____

PRODUCTION

1st 24 hrs. Nat. _____

1st 24 hrs. after shot _____

Gas _____ Cu. Ft.

Dry Hole _____

Abandoned _____

Date

DEC 29 1948 19

S. J. LEWIS Scout

Form 26 200 Bks. 9-48 Petrol

Wildcat

Kansas

Map No. 65 Sec. 19 Twp. 8 R. 19W

Well No. 1 Campbell


Sam Pack etal. Company

ABANDONED Contractor

SW/C

E.L. 2087

SECTION PLAT

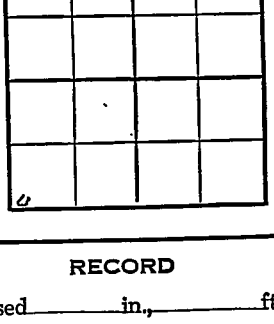

____ Ft. from N. Line

330 Ft. from S. Line

____ Ft. from E. Line

330 Ft. from W. Line

Rooks County

Location

Rig up

Drilling and Remarks:

Loans 3252.

Comp 3552

Cs 3516.

RECORD

Cased ____ in., ____ ft.

Sand

Gas

Oil

Total Depth 3537

PRODUCTION

1st 24 hrs. Nat.

1st 24 hrs. after shot

Gas ____ Cu. Ft.

Dry Hole

Abandoned

Date

JAN 12 1949

19

S. J. LEWIS Scout