


Rooks

Section 19 Township 8 Range 17W

Well No. #3 H. A. Krug

Company Shell Oil Company

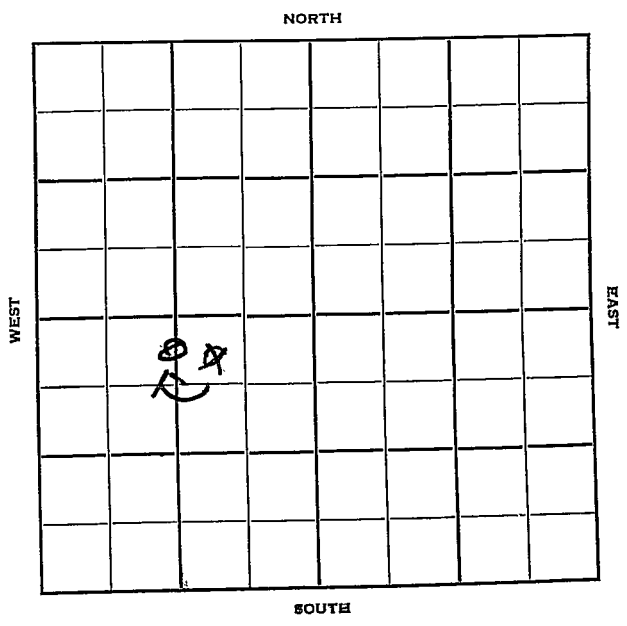



Sec. 19 Twp. 8 R. 17 W

Well No. # 3 H. A. Krug Farm

Shell Oil Company

Contractor

330 Ft. from N. Line

Ft. from S. Line


~~1320~~

~~1310~~

Ft. from E. Line

Ft. from W. Line

~~NW NE SW~~
C N/2 N/2 SW

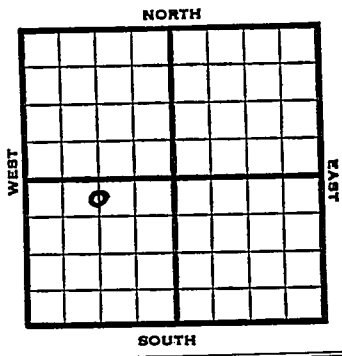

1953 Elev. 1961' REPORT

3/18 Spud 3-14-53
8" @ 1297

3/26 Top 2867, Heeb 3080, Tor 3098,
Lans 3121
Drlg. 3257

4/2 Arb. 3377 RTD 3379 5" @ 3378

4/9 DD 3381 dry DD 3384 TD
FU 3 BOPH 750 A S/ 9 1/2 Boph 6 hrs.
POP

4/16 "

4/23 NR

4/29 Spud 3-14-53
Oil Well
TD 3384
8" @ 1297
Heeb 3080, Tor 3098, Top 2867, Lans
3121, Arb. 3377
TD 3379
5" @ 3378
DD 3381, dry
DD 3384, FU 3 boph, 750A
S/9 1/2 boph
Comp. 103 bopd

COMPLETED

Kansas

Map No. _____ Sec. 19 Twp. 8 R. 17W

Well No. 3 H. A. Krug

Shell Oil Company

~~CORRECTIVE~~

Contractor

C N $\frac{1}{2}$ N $\frac{1}{2}$ SW

330 Ft. from N. Line

_____ Ft. from S. Line

1320 Ft. from E. Line

_____ Ft. from W. Line

SECTION PLAT

Rooks County

Location _____

Rig up _____

Drilling and Remarks:

Reported

NW NE SW

RECORD

Cased _____ in., _____ ft.

Sand _____

Gas _____

Oil _____

Total Depth _____

PRODUCTION

1st 24 hrs. Nat. _____

1st 24 hrs. after shot _____

Gas _____ Cu. Ft.

Dry Hole _____

Abandoned _____

Date

MAR 1 8 1953

J. G. McGEHEE

Scout

County Rooks State Kansas

Sec. 19 (Blk. Twp.) 8 (Sur. Rge.) 17W Map No.

Operator Shell Oil

Well No. 3 Farm H. A. Krug

Elev. _____ Location NW NE SW

330 Ft. From N Line SW

1310 Ft. From E Line Quarter

Ist. Report MAR 18 1953

Completion _____

Remarks _____

Spudding Date 3-14-53

Drig. Data _____

8" @ 1297

