


Section 19 Township 8 Range 17 W

Well No. #7 H. A. Krug

Company Shell Oil

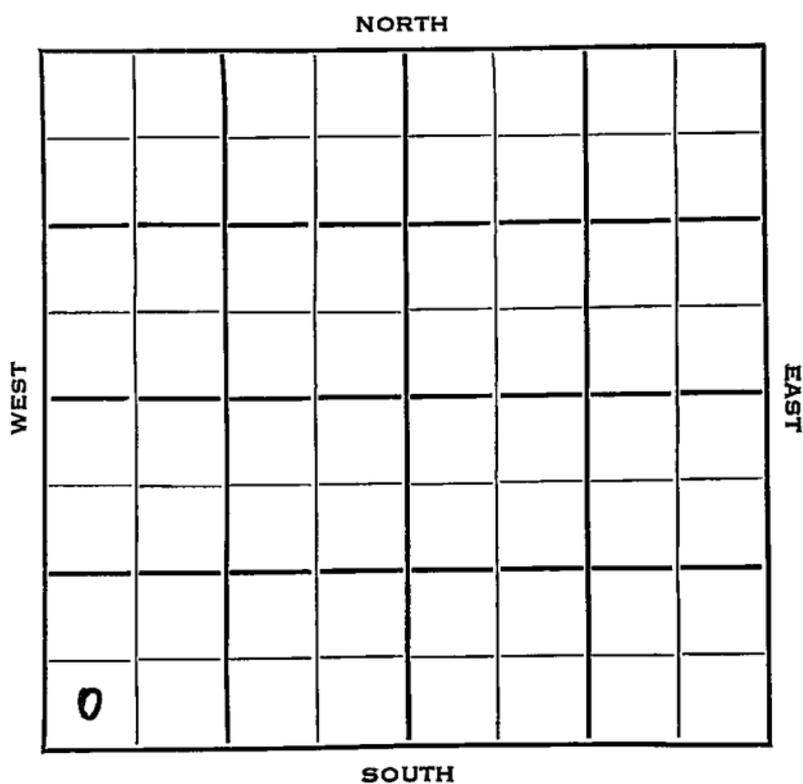

Rooks

KANSAS

SEC. 19	TWP. 8	R. 17W ✓
---------	--------	----------


WELL NO. #7 H.A. Krug FARM

COMPANY Shell Oil

CONTRACTOR Sidey

Elm Creek Pool

_____ Ft. from N. Line
 330 _____ Ft. from S. Line
 _____ Ft. from E. Line
 330 _____ Ft. from W. Line

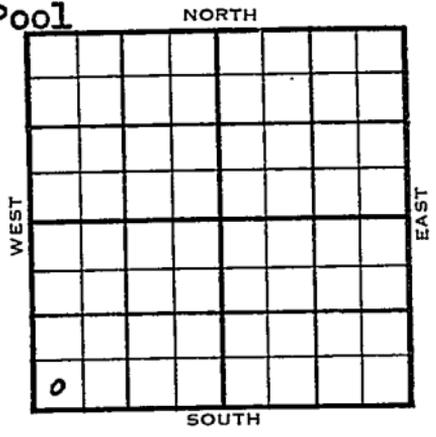

SW SW SW

	ELEVATION	REPORT
1953	1993'	
11/18		Spud 11-16-53 Drlg 1095'
1954 1/6		Spud 11-16-53 Oil well TD 3414 8" @ 1310 Anhy 1298 Lans. 3146 Arb. 3402 TD 3404 5 1/2" @ 3403 Heeb 3102 Tor. 3124 CO to 3404 DD 3414 FU 1250' fluid 4 1/2 hr. S/6 1/2 BOPH 8 hr. 1000 A S/13 1/2 BOPH Comp. 2104 BOPD

COMPLETED

