FORM 51

Rooks KANSAS

Section 19 Township 8 Range 17 W

Well No. # 8 Krug

Company Shell Oil

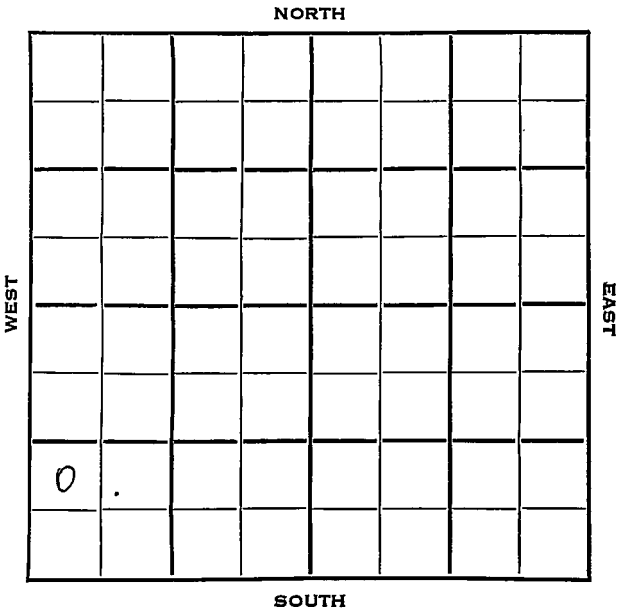

Rooks KANSAS

SEC.	TWP.	R.
19	8	17 W

WELL NO. # 8 Krug FARM

COMPANY Shell Oil

CONTRACTOR Sidey

Elm Creek Pool

_____ Ft. from N. Line

990 Ft. from S. Line

_____ Ft. from E. Line

330 Ft. from W. Line

NW SW SW

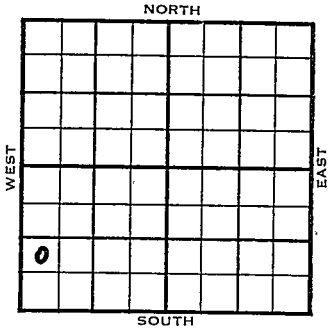

1953	ELEVATION 1993' REPORT
12/2	Spud 11-28-53 8" @ 1319 Anhy 1309 Drlg. 1510'
12/9	Lans. 3149 Arb. 3408 RTD 3410' Schl
12/16	DD 3416' TD S/2½ boph 7 hrs., 1000A S/13 boph 6 hrs.
1954 1/6	NR
1/13	Spud 11-28-53 Oil Well TD 3416' 8" @ 1319' Anhy 1309', Top 2897', Heeb 3107', Tor 3128', Lans 3149' Arb 3408' TD 3410' 5" @ 3409' DD 3416' S/ 2½ boph 7 hr. 1000 A S/ 13 boph Comp 339 bopd.

COMPLETED

DX-78

FORM 275 FOR SALE BY KANSAS BLUE PRINT CO.

County Rooks State Kansas

Sec. 19 (Blk. Twp.) 8 (Sur. Rge.) 17W Map No.

Operator Shell Oil

Well No. 8 Farm Krug

Elev. Location NW SW SW

FIRST REPORT

990 Ft. From S Line SW

330 Ft. From W Line Quarter

1st. Report DEC 2 1953

Completion

Remarks

Sidey - Contr.

Spudding Date 11-28-53

Drlg. Data Elm Creek Pool

8" @ 1319 Anhy 1309 drlg. 1510

J. G. McGEHEE

FORM 275 FOR SALE BY KANSAS BLUE PRINT CO.

County Rooks State Kansas

Sec. 19 (Blk. Twp.) 8 (Sur. Rge.) 17W Map No.

Operator Shell Oil

Well No. 8 Farm Krug

Elev. 1993 Location NW SW SW

COMPLETE

990 Ft. From S Line SW

330 Ft. From W Line Quarter

1st. Report

Completion JAN 13 1954

Remarks Elm Creek Pool

Sidey - Contr.

Spudding Date 11-28-53

Drlg. Data Oil well TD 3416

8" @ 1319 Anhy 1309 Top. 2897

Heeb. 3107 Tor. 3128 Lans. 3149

Arb. 3408 TD 3410 5" @ 3409 DD 3416

S/ $2\frac{1}{2}$ boph 7 hr. 1000 A S/ 13 boph

Comp. 339 bopd

J. G. McGEHEE