


Section 19 Township 8 Range 17 W

Well No. # 5 Krug

Company Shell Oil

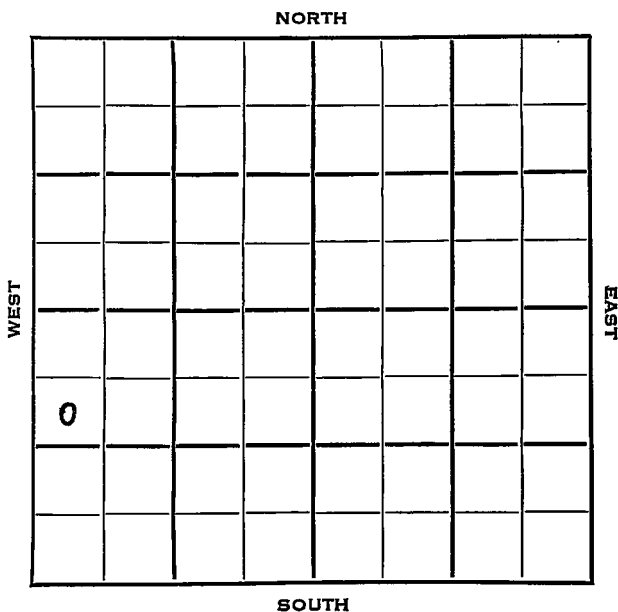

Rooks

KANSAS

SEC.	19	TWP.	8	R.	17W	✓
------	----	------	---	----	-----	---

WELL NO. #5 Krug FARM

COMPANY Shell Oil


CONTRACTOR Sidey
Elm Pool

993 _____ Ft. from N. Line

_____ Ft. from S. Line

_____ Ft. from E. Line

330 _____ Ft. from W. Line

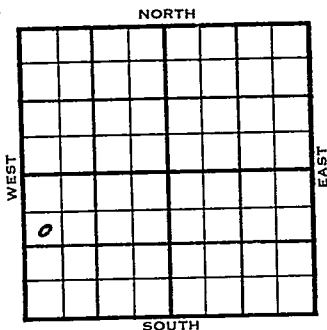

SW NW SW

1953	ELEVATION	REPORT
	1990'	

10/21 Spud 10-20-53
Drlg 350'

10/28 NR

11/4 Heeb 3104' Tor 3126' Lans 3147'
Arb. 3406' RTD 3408' 5" @ 3407'
DD 3413' TD FU 150' oil 1 hr.

11/11 500 A S/11½ BOPH 7 hrs.

11/18 Spud 10-20-53

Oil Well

TD 3413'

Heeb 3104', Tor 3126', Lans 3147',

Arb 3406'

TD 3408'

5" @ 3407'

DD 3413'

FU 150' oil 1 hr. 500 A

S/ 11½ boph 7 hr.

Comp 215 bopd.

COMPLETED

