


SECTION 19 TOWNSHIP 8 RANGE 17W

WELL NO. #1 Reeder

COMPANY # D.G. Hansen

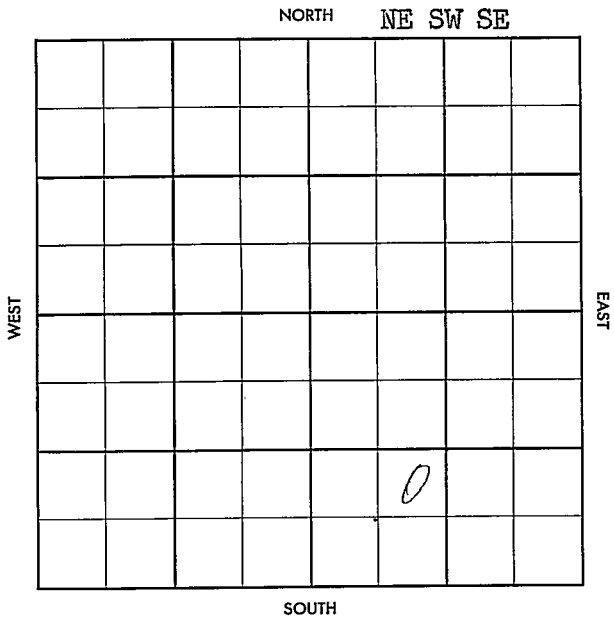



Co.

County Rooks Elev. 1954  
 Sec. 19 Twp. 8 Rge. 17W  
 Company D. G. Hansen  
 Farm Name Reeder No. 1

TOPS	DEPTH	LOG	DATUM	Loc. in Sec.
Anh.	1278			NE SW SE
Tp.	2855			
H.	3026			
Tr.	3087			
Dg.				
BL				
L.	3108			Geol.
K.C.				Contr. <u>Cook &amp;</u>
B.K.C.	3337			<u>Galloway Tls</u>
Ce.				
C.				
M.				Pool
M.				<u>Flm Creek</u>
K.				
Mz.				
Me.				
V.				
S.				
S.				COMPLETE
A.	3372			
R.				
PE.				JUN 12 '57
G.				
TD.	3380			

Lsa

No.

Sec.

T.

R.

Date Comm. Cities Service (F0)Location 57 4-10-57 8578162.50 DST 3071-3100 1hr.rec 33' JCM BHP 137 APR. 4 '57DST 3181-3200 1hr. rec 30' GCM+ 9' HSC' GCM BHP 118 DST 3203-15 90" rec. + 2' HSCM + 30'W8'0CM BHP 918 5 1/2 @ 33731100 MAY 7 '57 " DD 3381 1/23/4 Box 1/2 8 1/2 Bspk MAY 5 '57

DD 3388 1 1/2 8 3 Bopk

no/wt 4hr MAY 22 '57 MAY : '57 P/P

JUN 5 '57 JUN 2 '57 P. 2 1/2 Bopk

no/wt es/ P. 25 Bopk

no/wt.