

Rooks


KANSAS

SECTION 19 TOWNSHIP 8 RANGE 17W

WELL NO. #3 Reeder

COMPANY D.G. Hansen

NORTH S/2 S/2 SE

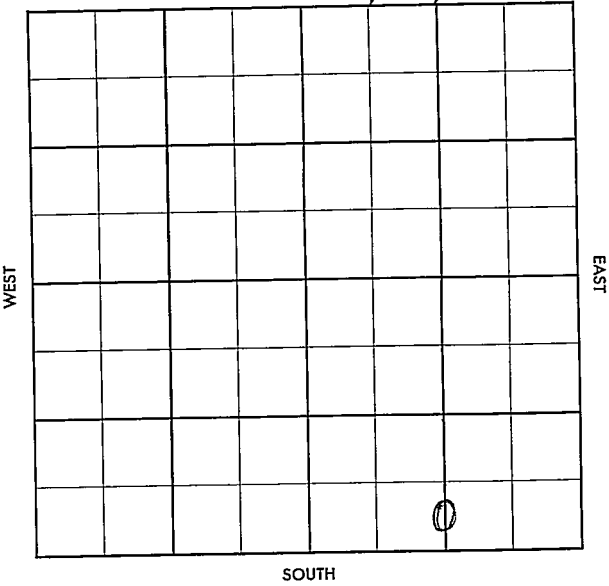

County Rooks Elev. \_\_\_\_\_  
 Sec. 19 Twp. 8 Rgs. 17W  
 Company D. G. Hansen  
 Farm Name Reeder No. 3

	TOPS	DEPTH	LOG	DATUM
Anh.				
Tr.				
H.				
Tr.				
Dg.				
Bl.				
L.				
K.C.				
B.K.C.				
Ce.				
C.				
M.				
M.				
K.				
Mz.				
Me.				
V.				
S.				
S.				
A.				
R.				
Pe.				
G.				
T.D.				

Loc. in Sec. S/2 S/2 SE  
 Geol. \_\_\_\_\_  
 Contr. Cook & Galloway  
 Pool Elm Creek  
 AUG 14 1957  
 FIRST REPORT

Date Comm. 8-13-57  
Spudding

6

Co.

Sec.

No.

Sec.

T.

R.

County Rooks Elev. 1961 DF  
 Sec. 19 Twp. 8 Rge. 17W  
 Company D. G. Hansen  
 Farm Name Reeder No. 3

TOPS	DEPTH	LOG	DATUM	Loc. in Sec.
Anh.	<u>1286</u>			<u>S/2 S/2 SE</u>
Ip.	<u>2870</u>			
H.	<u>3077</u>			
Tr.	<u>3096</u>			
Dg.				Geol.
Bl.				
L.	<u>3118</u>			Contr. <u>Cook &amp; Galloway</u>
K.C.				
B.K.C.				Pool
Ce.				
C.				<u>Elm Creek</u>
M.				
M.				<div style="border: 1px solid black; padding: 5px; text-align: center;">                 COMPLETE                  SEP 11 '57             </div>
K.				
Mz.				
Mo.				
V.				
S.				
S.				
A.	<u>3386</u>			
R.				
PE.				
G.				
TD.	<u>3390</u>			

Date Comm. 8-13-57 8 167/15054  
 Spudding 300-1' 57 DST 3083-3112 op 1 hr,  
485 GIP R495 OCM 200' oil DST 1150  
FBH 645 DST 3108-35 op 1/2 120 GIP, 75  
40 OCM EBHP 1220, FBHP 310 DST 3185-3210  
10 1/2 7' m. BHP 105, DST 3209-19 op 1 hr,  
360' manta-BHP 1153# FBHP 825 25280  
AUG 28 57 DST 3268-86 30" 12' Md +  
.550 BHP 865/20" DST 3306-31  
1 hr. 23' OCM BHP 140 5 1/2 3387

19 - 8 - 17W

FORM 513-1 SUNRAY

CA 3390 RTP \$

11 Goph + Tr. wt. 4 lines

DD 3392 \$ 40 Goph + Tr.

wt. 4 lines DD 3394 \$

1 1/2 Boph + Tr. wt. 6 lines

1 1/2 \$ 5 Boph + Tr. wt.

9 line POY SEP 11 57 Unproccated

comp 25 Bopd + Tr. wt.

Arb O.H. 3387- 3394 TD