


Rooks

KANSAS

SECTION 19 TOWNSHIP 8 RANGE 17W

WELL NO. #4 Reeder

COMPANY D.G. Hansen

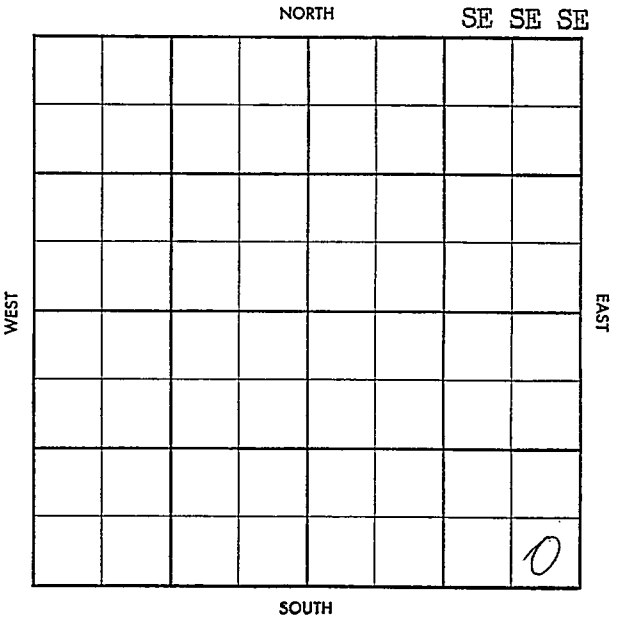

CO. Rooks ELEV. _____
SEC. 19 TWP. 8 RGE. 17W
COMPANY D.G. Hansen NO. 4

FIRST REPORT

OCT 16 '57

FARM Reeder

LOC. SE SE SE

Tops	
Anh 1275	
Heeb3052	
Tor 3071	

GEOLOGICAL _____
CONTRACTOR Cook & Galloway
POOL Elm Creek
SPUD 10/10/57
8" @ 170 w/150, DST
3057-85

LSE. NO. SEC. TWP. RGE.

S-513-A

CO. Rocks ELEV 1934 DF

SEC. 19 TWP. 8 RGE. 17W

COMPANY D.G. Hansen NO. 4

CO.			
NO.			
SEC.			
TWP.			
RGE.			
COMPLETE			
NOV 20 57			

FARM Reeder

LOC. SE SE SE

Tops
 Anh 1275
 Feet 3052
 Top 3075
 L 3092
 BKC 3320
 A 3367
 RTD 3362

GEOL. _____
 CONTR. Cook & Galloway
 POOL Ilm Creek
 SPUD 10/10/57
 8" - 170 W/1 " 57
 3057-85 " 30"
 10' M SD Oil BHP 56
 DST 3082-3108
 90" 25 GIP 40'
 MOCM BHP 116

DST 3136-55 90" 110' GIP 70'
 MOCM BHP 255 DST 3173-92
 60" 50' OCM 20' HOC Gassy M
 135' Gassy Omdy 151' W BHP
 912 DST 3237-60 60" 600
 GIP 65' HOCM 175' Mdy oil
 190' clean oil FPO-210 BHP
 1120 DST 3266-3300 90"
 60 GIP 30' HOCM 65' MOCM
 BHP 185 5 1/2" 3359 woct

MILT NOV. CO 3362 DD
3376 TD $\frac{1}{2}$ 490 ph $\frac{1}{2}$
 tested .8 Boph 2 hrs DD
3379 TD $\frac{1}{2}$ \$ 4 Boph 4 hrs
 POP NOV 20 57

25 BOPD NW

Arb open hole 3359-76

CO.
NO.
SEC.
TWP.
RGE.