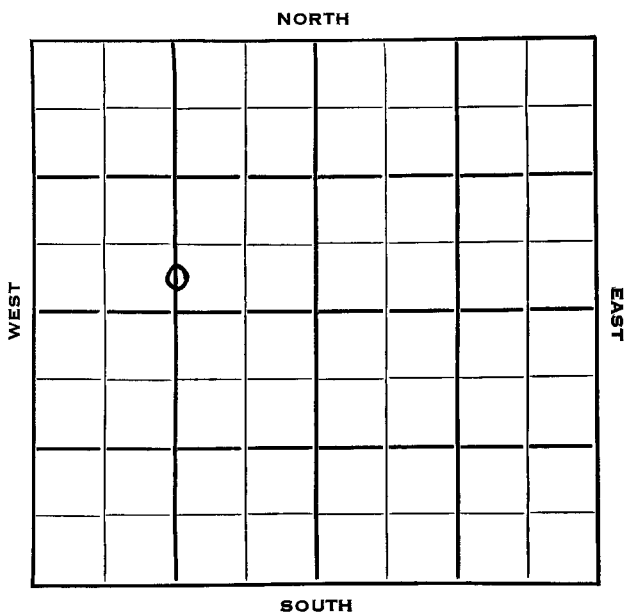


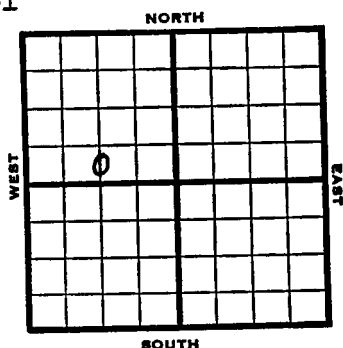
Well No. # 3 Schindler

Company V. D. Sidey



Rooks

KANSAS ✓

Sec. 19 Twp. 8 R. 17WWell No. #3 Schindler FarmV.D. Sidey CompanySidey ContractorElm Creek Pool Ft. from N. Line330 Ft. from S. Line Ft. from E. Line1320 Ft. from W. LineC $S\frac{1}{2}$ $S\frac{1}{2}$ NW

1953

Elev. 1978' REPORT

5/27 Spud 5-19-53
 8" @ 106'
 Drlg 2865'

6/3 Heeb 3100, KC 3142, Arb 3405
 RTD 3406
 5" @ 3406'

6/10 DD 3412
 B/4 boph

6/24 1000 A S/15 BOPH POP

7/1 Spud 5-19-53 Oil well TD 3412
 8" @ 106 Heeb 3100 KC 3142
 Arb 3405 TD 3406 5" @ 3406
 DD 3412 B/4 BOPH 1000 A S/15 BOPH
 Comp. 240 BOPD 6% wtr.

COMPLETED

County Rock State Kansas

Sec. **19** (Blk.) **8** (Sur.) **17W** Map No.

Operator V. D. Sidney

Well No. 3 Farm Schindler

Elev.	Location	C	S $\frac{1}{2}$	S $\frac{1}{2}$	NW
-------	----------	---	-----------------	-----------------	----

330 Ft. From S Line NW

1320 Ft. From W Line Quarter

1st. Report MAY 27 1953

Completion _____

Remarks _____

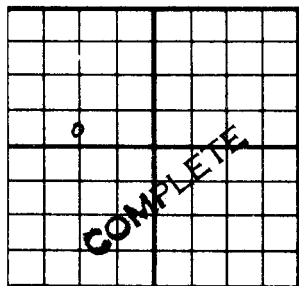
Sidey - Contr.

Spudding Date 5-19-63

Drig. Data Elm Creek Pool

8" @ 106 drlg. 2865

J. G. McGEHEE

County Rooks State KansasSec. 19 (Blk. Twp.) 8 (Sur. Rge.) 17W Map No.Operator V. D. SideyWell No. 3 Farm SchindlerElev. 1978 Location C S $\frac{1}{2}$ S $\frac{1}{2}$ NW330 Ft. From S Line NW1320 Ft. From W Line Quarter1st. ReportCompletion JUL 1 1953Remarks Elm Creek PoolSidey - Contr.Spudding Date 5-19-53Orlg. Data Oil well TD 34128" @ 106 Heeb. 3100 KC 3142Arb. 3405 TD 3406 5" @ 3406 DD 3412E/ 4 boph 1000 A S/ 15 bophComp. 240 bopd 6% wtr.