


Graham

KANSAS

SECTION 19 TOWNSHIP 8 RANGE 23W

WELL NO. #1 Brinkmeyer

COMPANY Leo J. Dreiling

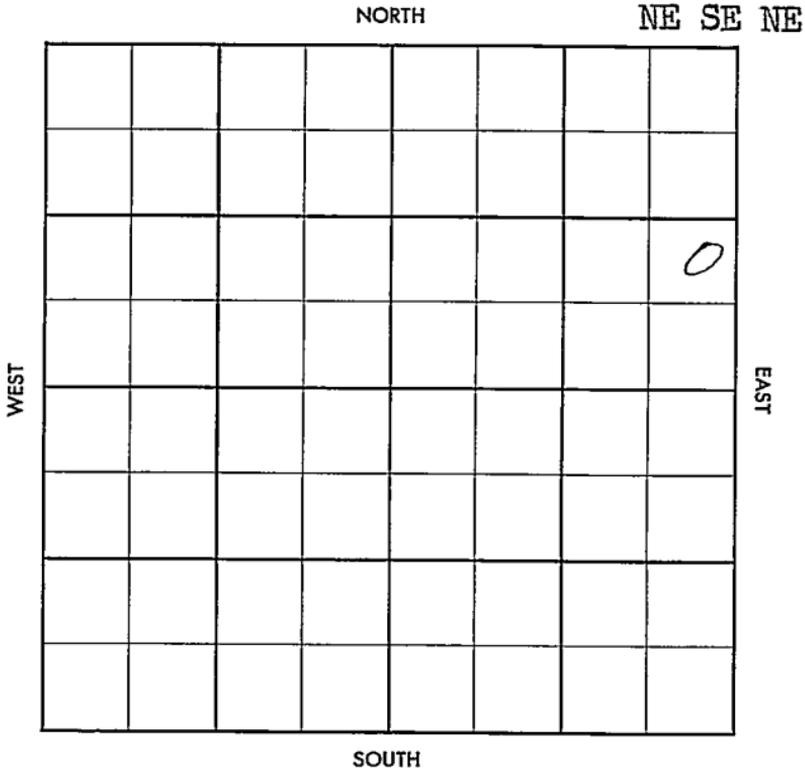

County Graham Elev. _____

Sec. 19 Twp. 8 Rgs. 23W

Company Leo. J. Dreiling

FarmName Brinkmeyer No. 1

TOPS	DEPTH	LOG	DATUM
Anb.			
Tr.			
H.			
Tr.			
Dg.			
Bl.			
L.			
K.C.			
B.K.C.			
Ce.			
C.			
M.			
M.			
K.			
Mz.			
Me.			
V.			
S.			
S.			
A.			
R.			
Pe.			
G.			
T.D.			

Loc. in Sec. _____

NE SE NE

Geol. _____

Contr. _____

V.D. Sidey

Pool _____

Higer

FIRST REPORT		
MAY 8 '57		

Date Comm. 5-6-57

Spudding

[Handwritten signature]

No. _____
 Sec. _____
 T. _____
 R. _____

Co.

County Graham Elev. 2191
 Sec. 19 Twp. 8 Rge. 23W
 Company Leo. J. Drilling
 FarmName Brinkmeyer No. 1

TOPS	DEPTH	LOG	DATUM
Anh.	1895		
TP.			
H.	3498		
Tr.			
Dg.			
BL.			
L.	3538		
K.C.			
B.K.C.			
Ce.			
C.			
M.			
M.			
K.			
Mz.			
Mo.			
V.			
S.			
S.			
A.			
R.			
PE.			
G.			
TD.	3740		

Loc. in Sec. 1E SE 1E
 Geol. _____
 Contr. V.D. Sidey T
 Pool _____
 Higer _____

JUL 3 '57	
COMPLETE	

1st S.

No.

Date Comm. 5-6-57
 Spudding MAY 15 57 8 5/8 @ 194/150
M. 3430 MAY 22 57 DST 3.83 - 3709
In sec 110' Fluid (80' oil + 30'
of 6CM) FP 50-100 J.M.P 900/20
5 1/2 2739 1/2 / 100 WUCT MAY 25 57
C.O 3719 24' 3690-96 3 5'
rate 20 Bopd nat. w. P.P. JUL 1 57
JUN 2 57 "IN 1 57 JUL 2 57 P.H.P.
80 Bopd + Trace wt. Gas 42°

Sec.

T.

R.