


Graham

KANSAS

SECTION 19 TOWNSHIP 8 RANGE 23W

WELL NO. #1 Lang Higer "B"

COMPANY Leo J. Dreiling Oil Co.

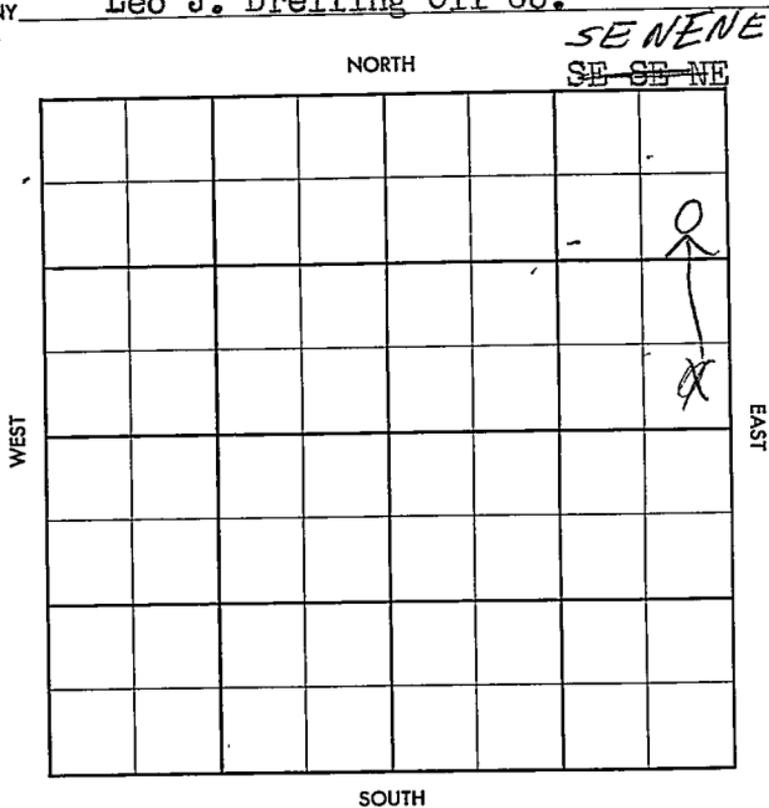

County Graham Elev. _____
 Sec. 19 Twp. 21 Rge. 23W
 Company Leo J. Dressing Oil Co.
 Farm Name Lang No. 1

Co.

TOPS	DEPTH	LOG	DATUM
Anh.			
Ip.			
H.			
Tr.			
Dg.			
Bl.			
L.			
K.C.			
B.K.C.			
Ce.			
C.			
M.			
M.			
K.			
Mz.			
Me.			
V.			
S.			
S.			
A.			
R.			
Pe.			
G.			
T.D.			

Loc. in Sec. SE SE NE

Geol. _____

Contr _____

V.D. Sidey T.M.S.

Pool _____

FIRST REPORT

APR 24 '57

L.S.B.

No.


Sec.

T.

R.

Date Comm. _____

Location _____

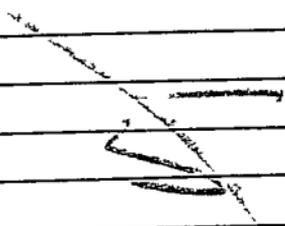

CORRECTION

County Graham Elev. 2187
 Sec. 19 Twp. 8 Rge. 23
 Company Leo J. Speer Linc Oil Co.
 Farm Name Lot Higer "B" No. 1

TOPS	DEPTH	LOG	DATUM	Loc-in-Sec
Anb.	1900			SE-SE NE SENE
Tp.				
H.	3491			
Tr.				
Dg.				
Bl.				
L.	3532			Geol.
K.C.				Contr.
B.X.C.				V.D. Sidey T
Ce.				Pool Higer
C.				
M.				
M.				
K.				
Mz.				
Mo.				
V.				
S.				
S.				
A.				
R.				
PE.				
G.				
T.D.	3740			

JUL 3 '57	
COMPLETE	

Date Comm.

Location MAY '57 Loc. 4-26-57
 8^{1/8} 182/150 DST 3593-3619
 or in rec 225' WM BHP 1175
 120" DST 3672-3753 in rec
 2760 GAS in pipe rec 1380
 clean oil FP 100-375 BHP
 250/20" 5^{1/2} 3739' 2' 100
 NOCT MAY '57 MICT CO MAY 22 '57 CO
 37.0 24 3688-90 FU 2800'

oil pins ~~1104~~ MAY 13 '57 3 5
 18 Bopk nslw P. 70 Bopd
 nslwtr JUN 5 '57 JUN 12 '57 JUN 19 '57
 with 3 '57 Ph P. 125 Bopd nslw
 gran 42°