


Section 2 Township 8 Range 19WWell No. #1 EllisCompany Mallard Drlg.

Wildcat

NORTH

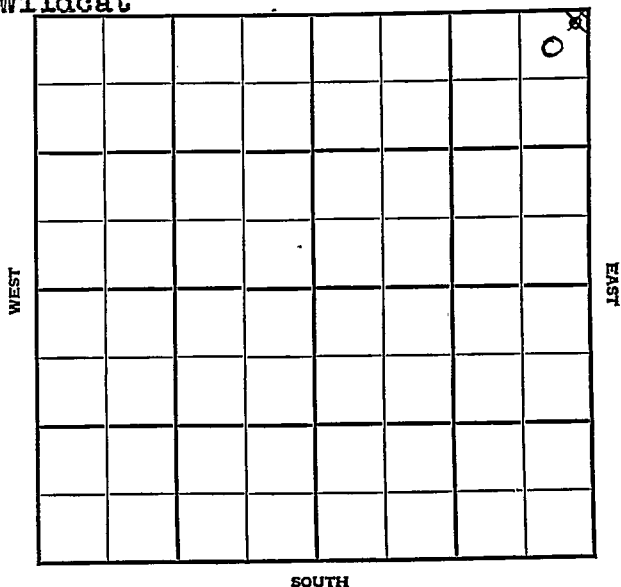

KANSAS

Rooks

Sec. 2 Twp. 8 R. 19-W

Well No. 1 Ellis Farm

Mallard Drlg. Company

Wildcat


330' Ft. from N. Line

Ft. from S. Line

330' Ft. from E. Line

Ft. from W. Line

NE/C

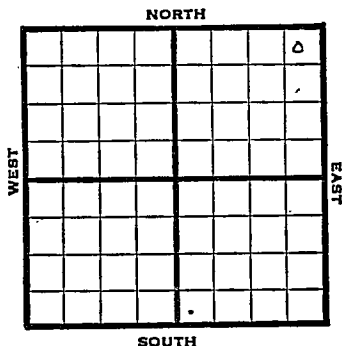

1947

Elev. 1842 REPORT

10/29

RUR

11/5

10" @ 189'
Anhydrite 1040'
Drlg. 1055'

11/12

Drlg. 1500'

11/25

Lansing 3018
BKA 3302
Cong 3324
Arbuckle 3350
TD 3890

ABANDONED

Kansas

Map No. _____ Sec. 2 Twp. 8 R. 19WWell No. 1 Ellis

Mallard Drlg. _____ Company

FIRST REPORT

Contractor _____

NE/C


SECTION PLAT

330 Ft. from N. Line

_____ Ft. from S. Line

330 Ft. from E. Line

_____ Ft. from W. Line

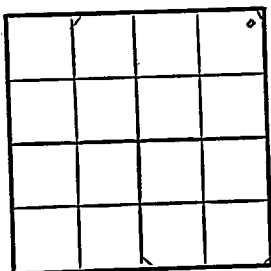

Rooks County

RECORD

Location _____

Cased _____ in., _____ ft.

Rig up _____

Sand _____

Drilling and Remarks:

Gas _____

Oil _____

Total Depth _____

R U R

PRODUCTION

1st 24 hrs. Nat. _____

1st 24 hrs. after shot _____

Gas _____ Cu. Ft.

Dry Hole _____

Abandoned _____

Date

OCT 29 1947 19

S. J. LEWIS

Scout

Map No. 165 Sec. 2 Twp. 8 R. 19W

Well No. 1 Ellis

Mallard Drlg. Company

ABANDONED

Contractor

NE/C


E. 1842
SECTION PLAT

330 Ft. from N. Line

 Ft. from S. Line

330 Ft. from E. Line

 Ft. from W. Line

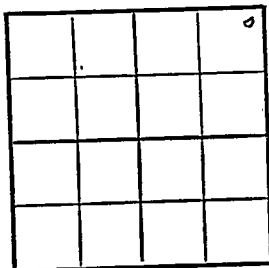

Rooks County

RECORD

Location

Cased in., ft.

Rig up

Sand

Drilling and Remarks:

Gas

Line 3018.

Oil

OK 3302.

Total Depth 3370

Comp 3324

Art 3358

PRODUCTION

1st 24 hrs. Nat.

1st 24 hrs. after shot

Gas Cu. Ft.

Dry Hole

Abandoned

Date

NOV 25 1947

19

S. J. LEWIS

Scout