


Section 2 Township 8 Range 24W

Well No. 1 Welty

Company Barnett & Shields

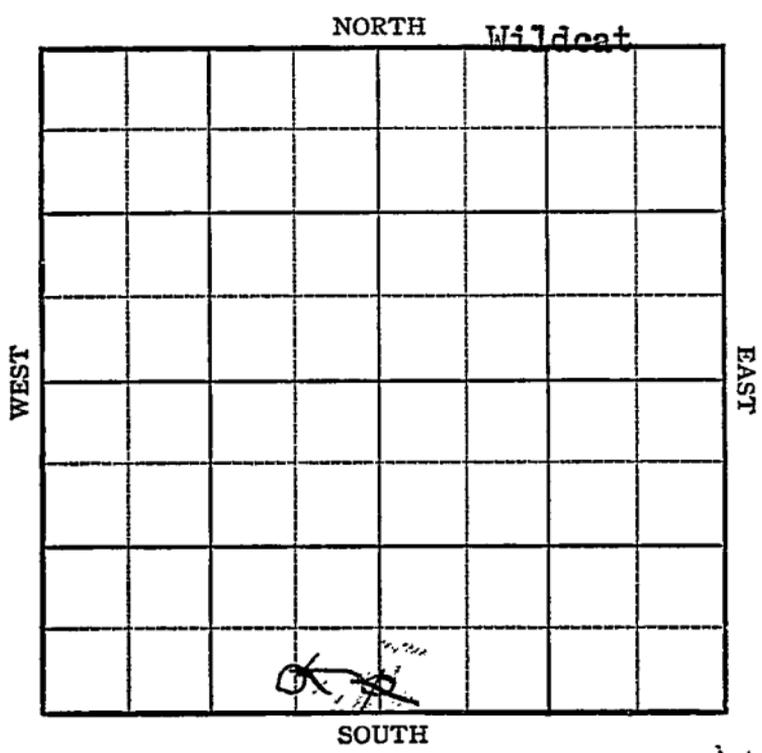

14

22

KANSAS

Graham

Sec. 2 Twp. 8 R. 24W

Well No. #1 Welty Farm

Barnett & Shields Company

Wildcat


_____ Ft. from N. Line

330' Ft. from S. Line

660' Ft. from E. Line

_____ Ft. from W. Line

C S L SE SW

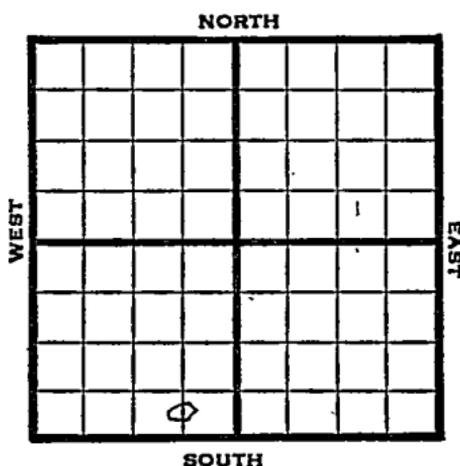

1948

Eli 2343'

REPORT

9/8

Location

9/15

Lansing 3601'

BKG 3837'

Cong 4025'

Arb. 4055'

TD 4079'

Aband.

ABANDONED

Graham County Kansas State
Map No. 66 Sec. 2 Twp. 8 R. 24W

Well No. 1 Welty

Barnett & Shields Company

ABANDONED

Contractor

C S L SE SW

E. 2343
SECTION PLAT

 Ft. from N. Line

330 Ft. from S. Line

660 Ft. from E. Line

 Ft. from W. Line

Wildcat

Remarks:

Lions 3601

BHC 3837

Cing 4025

Box 4055

AD 4079



2 150
200617

Date
SEP 15 1948

Scout **S. J. LEWIS**