

Graham

KANSAS

Section 2 Township 8 Range 24W

Well No. #3 Lyon

Company Barnett et al

Penokee Pool

NORTH

WEST

EAST

SOUTH

9

Graham County

Sec. 2 Twp. 8 R. 24W

Well No. #3. Lyon Farm

Barnett et al Company
Penokee Pool (Peel, Contr.)


990' Ft. from N. Line

 Ft. from S. Line

660' Ft. from E. Line

 Ft. from W. Line

C S L N E S E

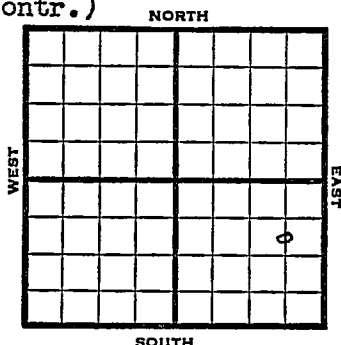

1949

Elev 2354'

R E P O R T

12/14

Location

12/21

"

12/28

"

1950

1/18

TD 3808'

5" @ 3807'

Perf 24/3793-99

Used 2300 acid

PP 50 BOPD

Comp

COMPLETED

Map No. _____ Sec. 2 Twp. 8 R. 24W

Well No. 3 Lyon

_____ Barnett et al. _____ Company

_____ Peel _____ Contractor
C S L NE SE

**FIRST REPORT
SECTION PLAT**

990 Ft. from N. Line

_____ Ft. from S. Line

660 Ft. from E. Line

_____ Ft. from W. Line

Graham County

Location X

Rig up _____

Drilling and Remarks:

RECORD

Cased _____ in., _____ ft.

Sand _____

Gas _____

Oil _____

Total Depth _____

PRODUCTION

1st 24 hrs. Nat. _____

1st 24 hrs. after shot _____

Gas _____ Cu. Ft.

Dry Hole _____

Abandoned _____

Date

DEC 14 1949 19

S. J. LEWIS

Scout

Kansas

Penokee Pool

Map No. _____ Sec. 2 Twp. 8 R. 24WWell No. 3 Lyon

Barnett et al. _____ Company

Contractor


C S L NE SE

F/V. 2354
SECTION PLAT990 Ft. from N. Line

_____ Ft. from S. Line

660 Ft. from E. Line

_____ Ft. from W. Line

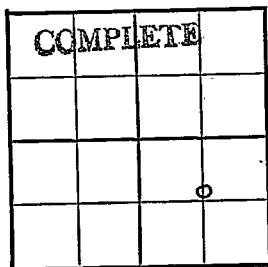

Graham County

Location _____

Rig up _____

Drilling and Remarks:

5" @ 3807Perf 24/3793-99
used 2300 acid
PP-50 BOPD

RECORD

Cased _____ in., _____ ft.

Sand _____

Gas _____

Oil _____

Total Depth 3808

PRODUCTION

1st 24 hrs. Nat. _____

1st 24 hrs. after shot _____

Gas _____ Cu. Ft.

Dry Hole _____

Abandoned _____

Date

JAN 18 1950

J. E. TYRA

Scout