


Section 2 Township 8 Range 24-W

Well No. #1 Welty

Company R W Shields et al

NORTH

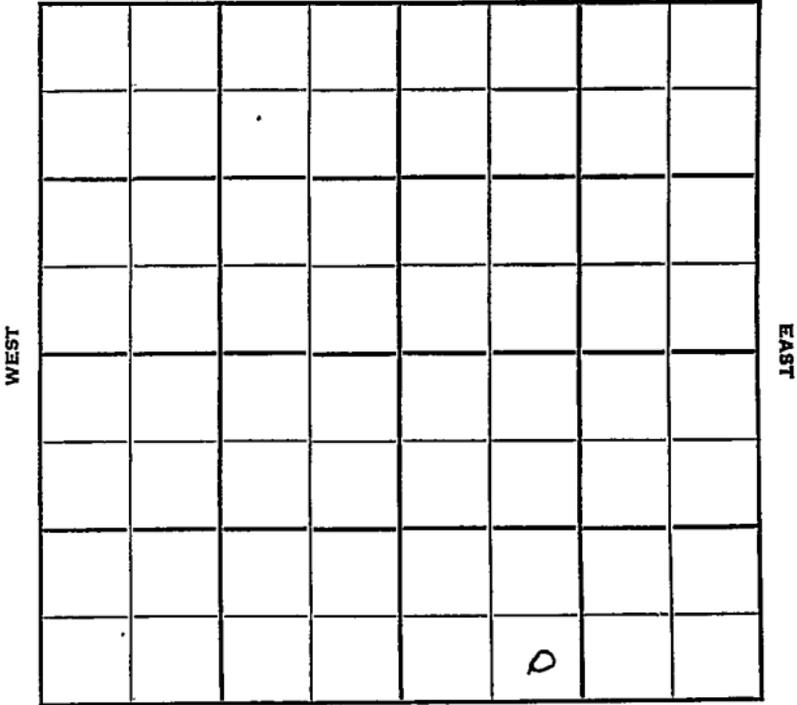

SOUTH

15

Graham  
8

KANSAS

Sec. 2 Twp. 8 R. 24W

Well No. #1 Welty Farm

R. W. Shields et al Company

Peel Drlg. Contr. Contractor

Penoke Pool


Ft. from N. Line

330' Ft. from S. Line

Ft. from E. Line

990' Ft. from W. Line

SE SW SE

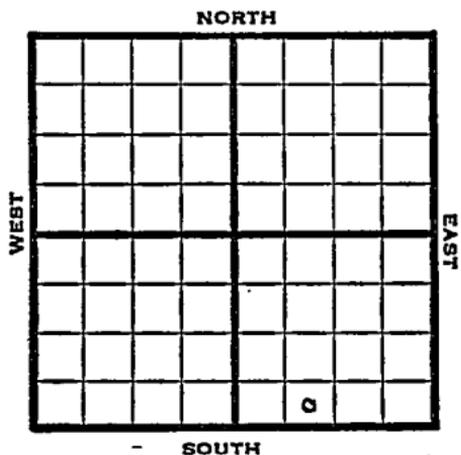

1950 Elev. 2316' REPORT

11/1 RUR  
 11/15 Spud 10-31-50  
 D&A TD 3846'  
 8" @ 145' Anhy 1965'  
 Heeb 3544' Lans. 3578'  
 BKG 3801' TD 3846'  
 D&A **ABANDONED**



