


Graham KANSAS

DX 78-1

Section 20 Township 8 Range 25W

Well No. 1 Schmied "B"

Company Bay Petroleum

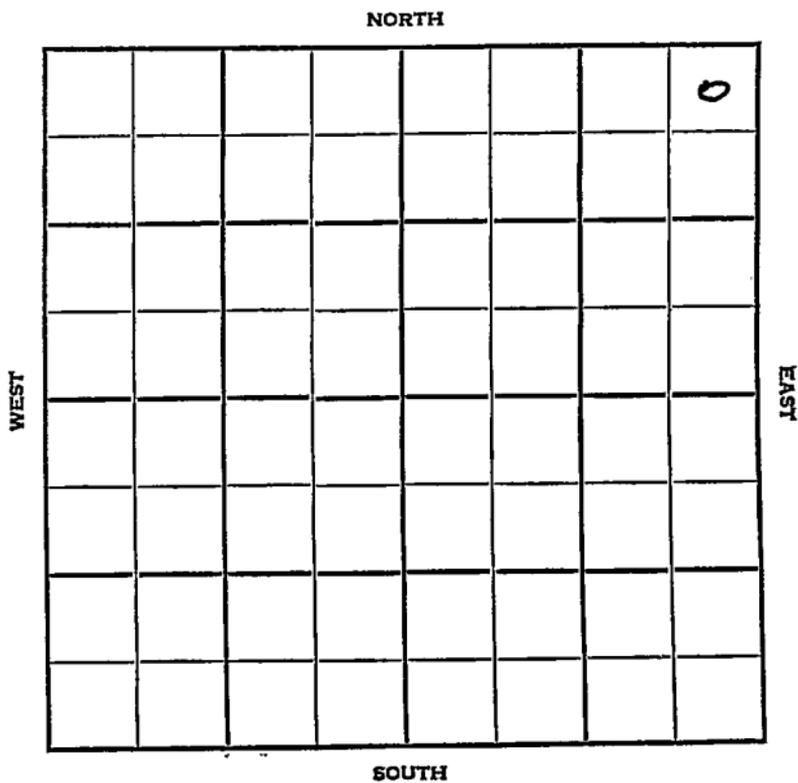

Graham KANSAS

SEC.	TWP.	R.
20	8	25W

WELL NO. **1 Schmied "B"** FARM

COMPANY **Bay Petroleum**


CONTRACTOR

330 Ft. from N. Line

_____ Ft. from S. Line

330 Ft. from E. Line

_____ Ft. from W. Line

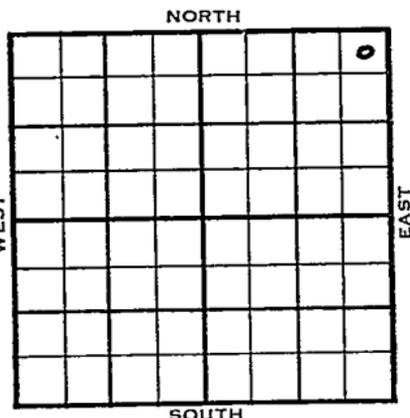

NE NE NE

1954	ELEVATION	REPORT
	2369'	

6/30

7/7

7/21

9/1

Location

"

8" @ 204 Heeb 3622' Tor 3646
Lans 3660

DST 3722-54, 1 hr, 30' M 0#

DST 3775-97, 1 hr, 5' M 110#

DST 3804-37, 1 hr, 1300' oil 480#

RTD 3889' 5" @ 3885

Spud 7-7-54 Oil well TD 3889

8" @ 204' Heeb 3622 Tor. 3646

Lans. 3660

DST 3722-54 open 1 hr rec 30' mud 0#

DST 3775-97 open 1 hr rec 5' mud. 110#

DST 3804-37 open 1 hr rec 1300' oil

480# TD 3889 5" @ 3885

Co to 3840 32/3828-36 S/16 BOPH

3000 A P/140 BO 12 hr. P/16 BOPH

8 hr. Comp. 494 BOPD

COMPLETED

