


Graham

KANSAS

SECTION 20 TOWNSHIP 8 RANGE 25 WWELL NO. #2 Schmied "B"COMPANY Tennessee Gas & Transmission

NORTH

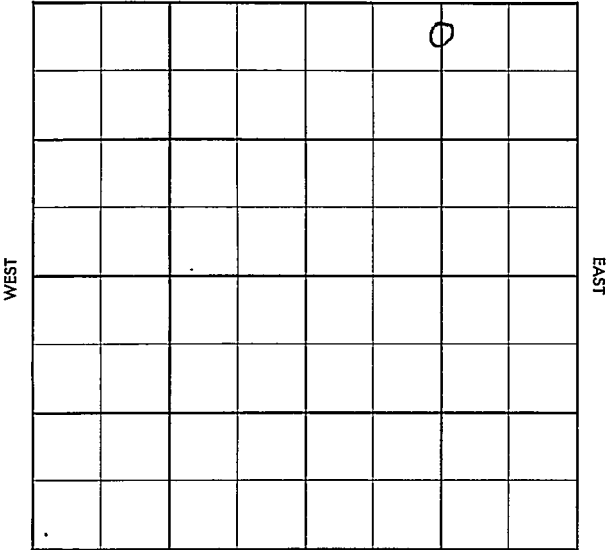

Graham

KANSAS

SEC.

20

TWP.

8

R.

25W

WELL NO.

# 2 Schmied "B"

FARM

COMPANY

Tennessee Gas &amp; Transmission

CONTRACTOR

Sterling


Schmied

Ft. from N. Line

Ft. from S. Line

Ft. from E. Line

Ft. from W. Line

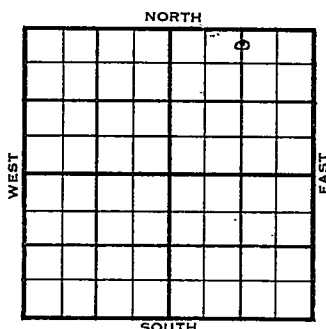C N $\frac{1}{2}$  N $\frac{1}{2}$  NE

1955

ELEVATION

2385'

REPORT

11-23

MIR

1956

1-11

Comm. 11-27-55

8 5/8" @ 238/175

DST 3695-3725 op 1 hr. rec. 25' wm,  
40' rotary mud 1185/20"DST 3755-70 op 1 hr. rec 25' drlg. mud  
0/20"DST 3796-3830 op 1 hr. rec. 5' drlg.  
mud, 110#DST 3828-65 op 1 hr. rec. 15' drlg. mud  
60#

5 1/2" @ 3898/100

CO 47/ 3852-60

S/ 16 bwph 3 hrs., 1000 A

S/ 26 bo , 7 1/2 bw 12 hrs.,

Comp. 52 bopd

H. 3645

Tr. 3667

L. 3685'

TD 3937'

COMPLETED

County Graham

Elev. \_\_\_\_\_

Sec. 20Twp. 8Rge. 25WCompany Tennessee Gas & TransmissionFarmName Schmied "B"No. 2

| TOPS   | DEPTH | LOG | DATUM | Loc. in Sec.                         |
|--------|-------|-----|-------|--------------------------------------|
| Anh.   |       |     |       | C N $\frac{1}{2}$ N $\frac{1}{2}$ NE |
| Tr.    |       |     |       |                                      |
| H.     |       |     |       |                                      |
| Tr.    |       |     |       |                                      |
| Dg.    |       |     |       |                                      |
| Bl.    |       |     |       |                                      |
| L.     |       |     |       | Geol. _____                          |
| K.C.   |       |     |       | Contr. _____                         |
| B.K.C. |       |     |       | Sterling                             |
| Ce.    |       |     |       |                                      |
| C.     |       |     |       | Pool _____                           |
| M.     |       |     |       | Schmied                              |
| M.     |       |     |       |                                      |
| K.     |       |     |       |                                      |
| Mz.    |       |     |       |                                      |
| Me.    |       |     |       |                                      |
| V.     |       |     |       |                                      |
| S.     |       |     |       |                                      |
| S.     |       |     |       |                                      |
| A.     |       |     |       |                                      |
| R.     |       |     |       |                                      |
| Pe.    |       |     |       |                                      |
| G.     |       |     |       |                                      |
| T.D.   |       |     |       |                                      |

|  |  |  |
|--|--|--|
|  |  |  |
|  |  |  |
|  |  |  |

FIRST REPORT

NOV 23 1955

Date Comm. \_\_\_\_\_

M I R

County Graham Elev. 2385  
 Sec. 20 Twp. 8 Rge. 25W  
 Company Tennessee Gas & Transmission  
 Farm Name Schmied "B" No. 2

Co.

Loc.

No.

Sec.

T.

R.

| TOPS   | DEPTH | LOG | DATUM | Loc. in Sec.   |  |  |   |  |  |  |  |  |  |  |  |  |  |  |  |  |  |  |  |  |  |  |  |  |
|--------|-------|-----|-------|---|--|--|---|--|--|--|--|--|--|--|--|--|--|--|--|--|--|--|--|--|--|--|--|--|
| Anh.   |       |     |       | C N $\frac{1}{2}$ N $\frac{1}{2}$ NE   |  |  |   |  |  |  |  |  |  |  |  |  |  |  |  |  |  |  |  |  |  |  |  |  |
| Tr.    | 3645  |     | 1260  |   |  |  |   |  |  |  |  |  |  |  |  |  |  |  |  |  |  |  |  |  |  |  |  |  |
| Dg.    | 3667  |     | 1282  |   |  |  |   |  |  |  |  |  |  |  |  |  |  |  |  |  |  |  |  |  |  |  |  |  |
| BL.    |       |     |       |   |  |  |   |  |  |  |  |  |  |  |  |  |  |  |  |  |  |  |  |  |  |  |  |  |
| L.     | 3685  |     | 1300  | Geol.   |  |  |   |  |  |  |  |  |  |  |  |  |  |  |  |  |  |  |  |  |  |  |  |  |
| K.C.   |       |     |       | Contr.   |  |  |   |  |  |  |  |  |  |  |  |  |  |  |  |  |  |  |  |  |  |  |  |  |
| B.K.C. |       |     |       | Sterling   |  |  |   |  |  |  |  |  |  |  |  |  |  |  |  |  |  |  |  |  |  |  |  |  |
| Ce.    |       |     |       | Pool   |  |  |   |  |  |  |  |  |  |  |  |  |  |  |  |  |  |  |  |  |  |  |  |  |
| C.     |       |     |       | Schmied   |  |  |   |  |  |  |  |  |  |  |  |  |  |  |  |  |  |  |  |  |  |  |  |  |
| M.     |       |     |       | <table border="1"> <tr><td></td><td></td><td>0</td></tr> <tr><td></td><td></td><td></td></tr> <tr><td></td><td></td><td></td></tr> <tr><td></td><td></td><td></td></tr> <tr><td></td><td></td><td></td></tr> <tr><td></td><td></td><td></td></tr> <tr><td></td><td></td><td></td></tr> <tr><td></td><td></td><td></td></tr> </table> |  |  | 0 |  |  |  |  |  |  |  |  |  |  |  |  |  |  |  |  |  |  |  |  |  |
|        |       | 0   |       |   |  |  |   |  |  |  |  |  |  |  |  |  |  |  |  |  |  |  |  |  |  |  |  |  |
|        |       |     |       |   |  |  |   |  |  |  |  |  |  |  |  |  |  |  |  |  |  |  |  |  |  |  |  |  |
|        |       |     |       |   |  |  |   |  |  |  |  |  |  |  |  |  |  |  |  |  |  |  |  |  |  |  |  |  |
| M.     |       |     |       |   |  |  |   |  |  |  |  |  |  |  |  |  |  |  |  |  |  |  |  |  |  |  |  |  |
| K.     |       |     |       |   |  |  |   |  |  |  |  |  |  |  |  |  |  |  |  |  |  |  |  |  |  |  |  |  |
| Mz.    |       |     |       |   |  |  |   |  |  |  |  |  |  |  |  |  |  |  |  |  |  |  |  |  |  |  |  |  |
| Mq.    |       |     |       |   |  |  |   |  |  |  |  |  |  |  |  |  |  |  |  |  |  |  |  |  |  |  |  |  |
| V.     |       |     |       |   |  |  |   |  |  |  |  |  |  |  |  |  |  |  |  |  |  |  |  |  |  |  |  |  |
| S.     |       |     |       |   |  |  |   |  |  |  |  |  |  |  |  |  |  |  |  |  |  |  |  |  |  |  |  |  |
| S.     |       |     |       |   |  |  |   |  |  |  |  |  |  |  |  |  |  |  |  |  |  |  |  |  |  |  |  |  |
| A.     |       |     |       |   |  |  |   |  |  |  |  |  |  |  |  |  |  |  |  |  |  |  |  |  |  |  |  |  |
| R.     |       |     |       |   |  |  |   |  |  |  |  |  |  |  |  |  |  |  |  |  |  |  |  |  |  |  |  |  |
| PE.    |       |     |       |   |  |  |   |  |  |  |  |  |  |  |  |  |  |  |  |  |  |  |  |  |  |  |  |  |
| G.     |       |     |       |   |  |  |   |  |  |  |  |  |  |  |  |  |  |  |  |  |  |  |  |  |  |  |  |  |
| T.D.   | 3937  |     |       | COMPLETE   |  |  |   |  |  |  |  |  |  |  |  |  |  |  |  |  |  |  |  |  |  |  |  |  |

Date Comm. 11-27-55 JAN 1 1 1956

8 5/8" @ 238/175 DST 3695-3725

open 1 hr. rec. 25' wm 40' rotary mud  
 1185/20" DST 3755-70 open 1 hr.

rec. 25' drlg. mud 0/20" DST 3796-3830

open 1 hr. rec. 5' drlg. mud 110#

DST 3828-65 open 1 hr. rec. 15' drlg.

mud 60# 5 1/2" @ 3898/100 GO

47/ 3852-60 S/ 16 bwph 3 hr. 1000 A

S/ 26 bo 7 $\frac{1}{2}$  bw 12 hr. Comp. 52 bopd

R.G.

JAN 20 1956