

Rooks

Section 20 Township 8 Range 20W

Well No. #1 Normandin

Company Deep Rock Oil

NORTH

WEST

EAST

0							

SOUTH

Rooks
8

KANSAS

Sec. 20 Twp. 8 R. 20W

Well No. #1 Normandin Farm

Deep Rock Oil Company

Creekmore Drlg. - Contr. Contractor


330' Ft. from N. Line

Ft. from S. Line

Ft. from E. Line

330' Ft. from W. Line

NW NW NW

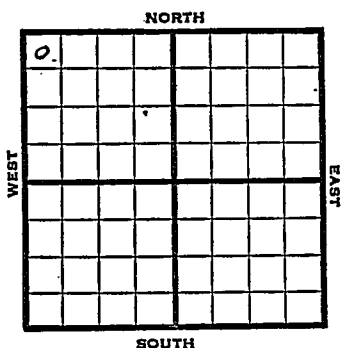

1951

Elev. 2063' REPORT

6/6

Location

6/27

Spud 6-11-51

D&A TD 3670

8" @ 216

Anhy 1630 Heeb. 3278

Lans. 3319

DST 3460-3540 opn $\frac{1}{2}$ hr Rec. 15' ocm

Arb. 3648 DST 3652-70 opn 1 hr

Rec. 285' sw

D&A

ABANDONED

County Rooks State KansasSec. 20 (Blk. Twp.) 8 (Sur. Rge.) 20W Map No.Operator Deep Rock OilWell No. 1 Farm NormandinElev. Location NW NW NW

0							

330 Ft. From N Line NW330 Ft. From W Line Quarter1st. Report JUN 6 1951

Completion

Remarks Shell DHMCreekmore Drig. - Contr.

Spudding Date

Drlg. Data

Location

J. E. TYRA

County _____ Rocks _____ State KansasSec. 20 (Blk. 8) (Sur. Rge. 20W) Map No. _____Operator Deep Rock OilWell No. 1 Farm NormandinElev. 2063 Location NW NW NW

0							

330 Ft. From N Line NW330 Ft. From W Line Quarter

1st. Report _____

Completion JUN 27 1951

Remarks _____

Creekmore Drlg. - Contr.Spudding Date 6-11-51Drlg. Data D & A TD 36708" @ 216 Anhy 1630 Heeb. 3278 Lans. 3319DST 3460-3540 open $\frac{1}{2}$ hr. Rec. 15' ocmArb. 3648 DST 3652-70 open 1 hr.Rec. 285' swD & A

J. E. TYRA