


Section 20 Township 8 Range 22W

Well No. #2 Moore

Company Deep Rock

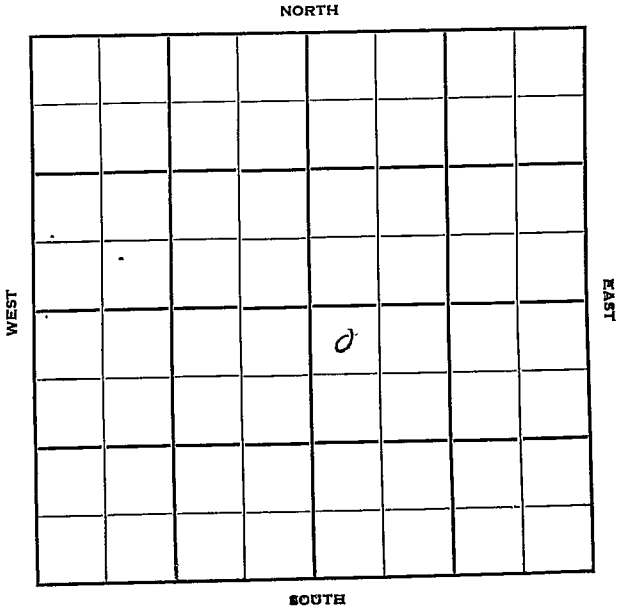

Graham

**KANSAS**

Sec. 20 Twp. 8 R. 22W

Well No. #2 Moore Farm

Deep Rock Company

Shell & Mag. Contractor

330 Ft. from N. Line


\_\_\_\_\_ Ft. from S. Line

\_\_\_\_\_ Ft. from E. Line

330 Ft. from W. Line

NW NW SE

Shell & Mag. DHM

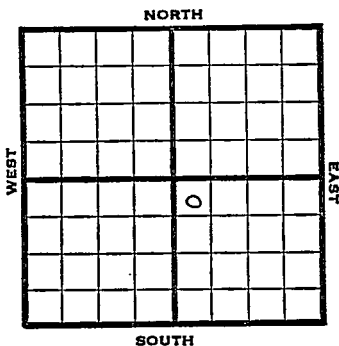

1951

Elev. 2197' REPORT

10/24

8" @ 136' WOC  
Spud 10-22-51

11/14

Spud 10-22-51  
D & A TD 3925' 8" @ 136  
Top 3201' Heeb 3415' Lans. 3454'  
DST 3514-40 open 50 min. rec 300' SW  
65' mud.  
Arb. 3891' TD 3925'  
DST 3592-3635' open 1 hr. rec 20' free  
oil, 20' HOCM.  
D & A

**ABANDONED**



County Graham State Kansas

Sec. 20 (Blk. 8 (Sur. 22W (Twp.) 8 (Rge.) 22W Map No.

Operator Deep Rock

Well No. 2 Farm Moore

Elev. 2197 Location NW NW SE


**ABANDONED**

330 Ft. From N Line SE

330 Ft. From W Line Quarter

Ist. Report

Completion NOV 14 1951

Remarks

Spudding Date 10-22-51

Drilg. Data D & A TD 3925

8" @ 136 Top. 3201 Heeb. 3415

Lens. 3454 DST 3514-40 open 50 min.

Rec. 300' sw 65' mud Arb. 3891

TD 3925 DST 3592-3635 open 1 hr.

Rec. 20' free oil 20' hocom

D & A

J. E. TYRA