

KANSAS

FORM 51 5M 4-41 PETROL

Sherman


Section 20 Township 8 Range 39-W

Well No. #1 Tompkins

Company Ingling & Parker

Wildcat

NORTH

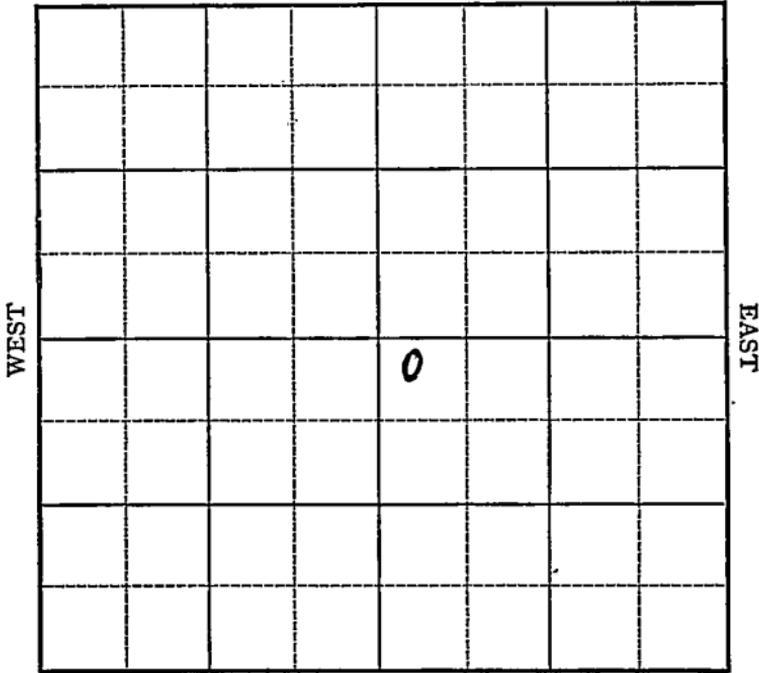

SOUTH

10

Sec. 20 Twp. 8 R. 39-W

Well No. 1 Tompkins Farm

Ingling & Parker Company


(Wildcat)

150 Ft. from N. Line

_____ Ft. from S. Line

_____ Ft. from E. Line

50 Ft. from W. Line

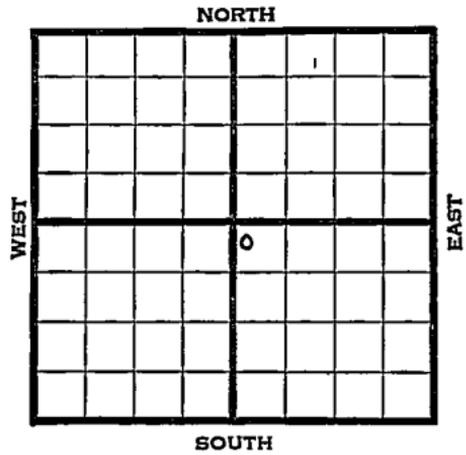

1941

REPORT

8/13

8" - 315

Show of gas 968-73

Drlg. 1068'

8/21

T.D. 2644' 8" - 1564'

8 shots 1530-39'

4 " 995-98'

11 " 1000-1010' 500 acid.

SS/Gas.

8/27

4" - 1564'

T.D. 2644'

500 acid.

ABANDONED

Map No. NM Sec. 20 Twp. 8 R. 39W

Well No. 1 Tompkins

Ingling & Parker Company

FIRST REPORT Contractor

NW SE

SECTION PLAT

150 Ft. from N. Line

_____ Ft. from S. Line

_____ Ft. from E. Line

50 Ft. from W. Line

		0	

WILDCAT

Location _____

Rig up _____

Drilling and Remarks:

8" - 315

Show of gas
968-73

Dr1g. 1068

RECORD

Cased _____ in., _____ ft.

Sand _____

Gas _____

Oil _____

Total Depth _____

PRODUCTION

1st 24 hrs. Nat. _____

1st 24 hrs. after shot _____

Gas _____ Cu. Ft.

Dry Hole _____

Abandoned _____

Date

AUG 13 1941 19

S. J. LEWIS Scout

Map No. NM Sec. 20 Twp. 8 R. 39 W

Well No. 1 Tompkins

Ingling & Parker Company

ABANDONED Contractor

SECTION PLAT

150 NW NE
Ft. from N. Line
____ Ft. from S. Line
____ Ft. from E. Line
50 Ft. from W. Line

		.	
		o	

WILDCAT

Location _____

Rig up _____

Drilling and Remarks:

4" C. 1564
500000

RECORD

Cased _____ in., _____ ft.
Sand _____
Gas _____
Oil _____
Total Depth 2644

PRODUCTION

1st 24 hrs. Nat. _____
1st 24 hrs. after shot _____
Gas _____ Cu. Ft.
Dry Hole _____
Abandoned _____

Date

AUG 27 1941 19

S. J. LEWIS Scout