KANSAS CORPORATION COMMISSION


Have log.

WELL RECORD

31-8-21W

15-065-20482

(Mail to Kansas Geological Survey, 4150 Monroe Street, Wichita, Kansas 67209)

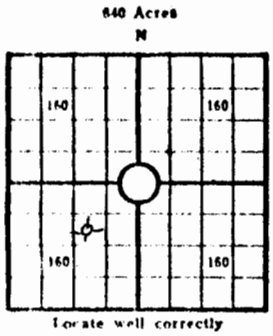

Lease Name: Irby Well No. 1
Well Located: Graham County
SW NE SW SEC 31 TWP 8S RGE 21W
Operator: Murfin Drilling Co.
Address: 617 Union Center, Wichita, Kansas 67202
Elevation: Ground 2142 D.F. 2144 K.B. 2147
Type Well: (Oil, gas, dry hole) Dry Hole

Drilling Commenced: 8-26 1971 Drilling Completed: 8-30 1971
Well Completed: 8-30 1971 Total Depth 3385'
Initial Production:

Casing Record

Size: 8 5/8 Set at 197' Size: Set at
Size: Set at Size: Set at

Liner Record

Size: Set from To

Cementing

Casing Size	Sacks	Type Cement and Additives
8 5/8	150	Sunset

Perforations

Formation	Perforated Interval and Number Shots

Electric Log Run. (Show type log and depths covered)

Dresser Atlas Gamma Ray - 3050 to 3384

Formation	Top	Bottom	Show Drill Stem Tests, Well Stimulation and Production Tests Cont. 31-8-21W
			NO TESTS
		40	Shale & Post Rock
		160	Sand Shale
		1175	Shale
		1395	Sand
		1656	Shale
		1688	Anhydrite
		2200	Shale
		3240	Lime & Shale
		3385	Lime

RECEIVED
STATE GEOLOGICAL SURVEY OF KANSAS
FEB 1972

5-1944

GEOLOGICAL SOCIETY
508 East Murdock
Wichita, Kansas

SEP 18 1971

31-8-21W
SW NE SW

WELL LOG

15-065-20482

COMPANY Murfin Drilling Company

SEC. 31 T. 8S R. 21W

LOC. SW NE SW

FARM Irby NO. 1

RIG. NO. 15

COUNTY Graham
KANSAS

TOTAL DEPTH 3385'

COMM. 8-26-71 COMP. 8-30-71

CONTRACTOR Murfin Drilling Company

CASING

20	10	
15	8	5/8" @ 197' w/150 sxs
12	6	
13	5	

ELEVATION 2142 GL
2147 KB

PRODUCTION D & A/LANS.

FIGURES INDICATE BOTTOM OF FORMATIONS

40	Shale & Post Rock
160	Sand Shale
1175	Shale
1395	Sand
1656	Shale
1688	Anhydrite
2200	Shale
3240	Lime & Shale
3385	Lime

LOG TOPS:

Stone Corral	1657
B " "	1688
Topeka	3111
Heebner	3327
Toronto	3354
Lansing	3372