

# KANSAS


FORM 51 5M 6-46 PETROL

Rookes County

Section 21 Township 8 Range 19W

Well No. 1 F. Veyerka

Company Shell

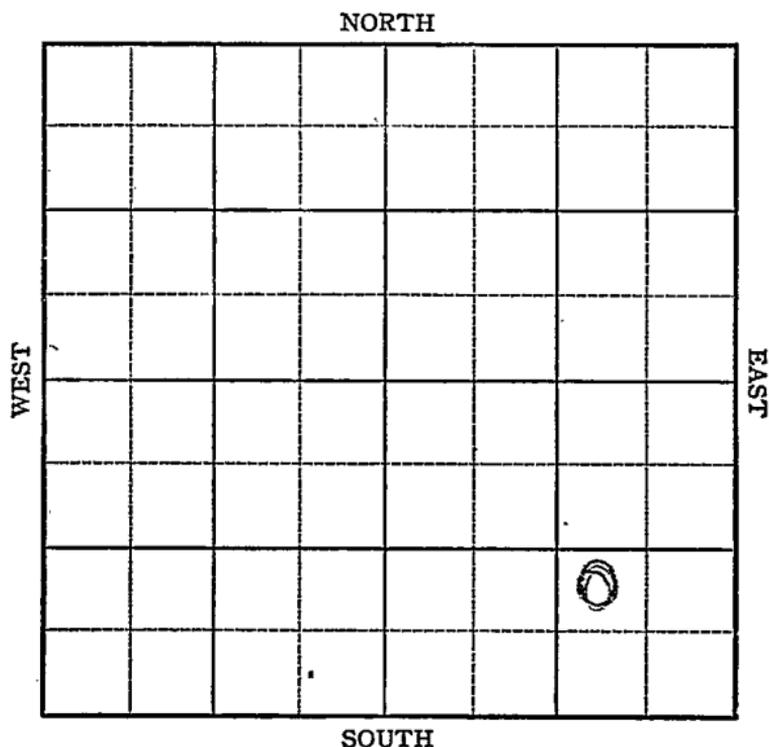

KANSAS

Rooks County



Sec. 21 Twp. 8 R. 19W

Well No. #1 F. Ververka Farm

Shell

Company

Ververka


\_\_\_\_\_ Ft. from N. Line

990 \_\_\_\_\_ Ft. from S. Line

990 \_\_\_\_\_ Ft. from E. Line

\_\_\_\_\_ Ft. from W. Line

NW SE SE

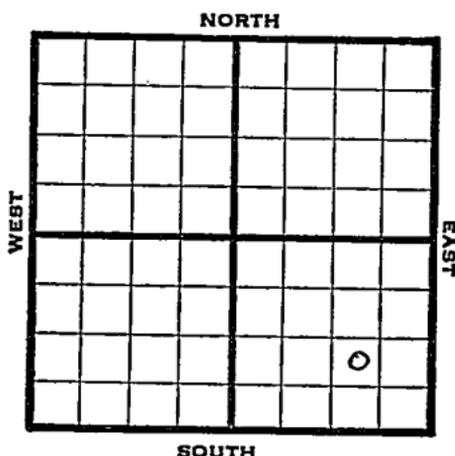

1946

*2008*

REPORT

8/7

13" @ 119  
Drlg. 440'

8/13

Anhy 1435  
Drlg 2300'

8/20

Topeka 2959  
Lans 3178  
Drlg 3297'  
8" @ 1434'

8/27

Arb 3443'  
TD 3450'  
4" @ 3444 RUST

9/5

1000 acid pump  
28 oil PH  
5 hrs plus 3% water

9/10

" " "

9/18

" " "

9/25

Arb 3443'  
4" @ 3444'  
TD 3450'  
Pump 218' POT  
Grav 24

COMPLETED

KANSAS Kansas Pool Name VeverkaMap No. 65 Sec. 21 Twp. 8 R. 19WWell No. 1 F. VeverkaShell

Company

FIRST REPORT

Contractor


NW SE SE

## SECTION PLAT

\_\_\_\_\_ Ft. from N. Line

990 Ft. from S. Line990 Ft. from E. Line

\_\_\_\_\_ Ft. from W. Line

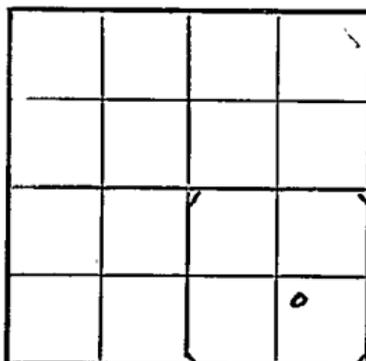Rooks County

## RECORD

Location \_\_\_\_\_

Cased \_\_\_\_\_ in., \_\_\_\_\_ ft.

Rig up \_\_\_\_\_

Sand \_\_\_\_\_

Drilling and Remarks:

Gas \_\_\_\_\_

Oil \_\_\_\_\_

13" @ 119

Total Depth \_\_\_\_\_

drlg. 440'

## PRODUCTION

1st 24 hrs. Nat. \_\_\_\_\_

1st 24 hrs. after shot \_\_\_\_\_

Gas \_\_\_\_\_ Cu. Ft.

Dry Hole \_\_\_\_\_

Abandoned \_\_\_\_\_

Date

AUG 7 1946 19S. J. LEWIS

Scout

