

Rook Rooks Co


Form 51-5M-2-29-34703

Map No. **KANSAS** Sec. *21* Twp. *8* R. *19w*

Well No. *1-Silver* Farm

H. R. Boyesen et al Company

NORTH

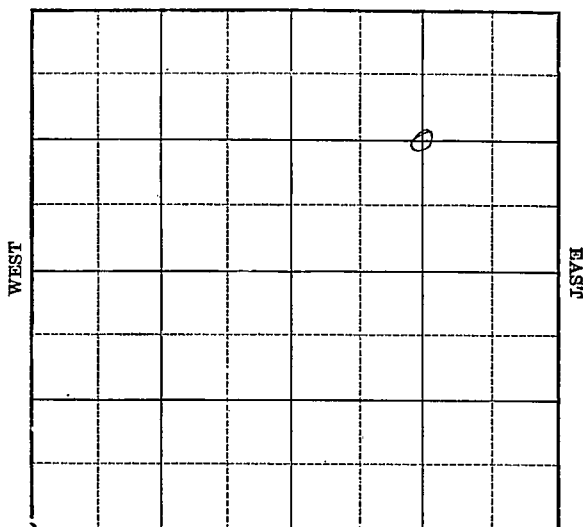

SOUTH

OWDID

Location

Drilling Remarks

Rig Up

Drilling Remarks

RECORD

Cased _____ in. _____ ft.

Sand _____

Gas _____

Oil _____

Total Depth _____

PRODUCTION

1st 24 hrs. Nat. _____

1st 24 hrs. after shot _____

Gas _____ cu. ft.


Dry Hole _____

Abandoned _____

Form 5M-11-29-38055

Map No. KANSAS Sec. 21 Twp. 8 R. 19^w
 Well No. 1- Siloos Farm
H. R. Bryson et al Company

NORTH

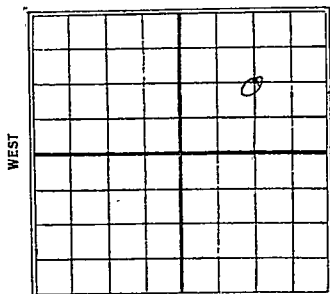

SOUTH

Ft. from N. Line

1320 Ft. from S. Line

1320 Ft. from E. Line

Ft. from W. Line

1930

Date

REPORT 4000' test

5/7	Loc
5/14	—
5/21	—
5/28	—
6/4	—
6/11	—
6/18	Roll
6/25	—
7/2	Rign up
7/9	haly 550'
7/16	" 900'
7/23	" 1115'
7/30	" 1200'
8/6	" 1250'
8/13	" 1420'
8/20	" 2100'
8/27	" 2760'
9/3	5/8" 8"- 2870'
9/10	Cand 3200-06
	Bailed 12 bbls 6 hrs.
	(over)

9/17- T.D. 3204' (SLM corr.)
 swab 3 bbl per hr
 9/24- S.D. 3204' trace water
 10/1- 6" - 3255'
 wellg. 3270'
 10/6- Top Pay 3435
 wellg. 3440' Hall
 find 9100 ft oil 1 hour
 10/8 TD. 3440
 swab 145 bbl 10 hr
 32° gravity
 UIR 6" csg.
 10/15- T.D. 3440
 swab 20 bbl per hr
 300 ft off bottom
 25° grav
 10/22 —
 10/29 —
 11/5- S.D. 3440'
 11/12- Sand 3435-40
 TD. 3445
 swab 20 bbl. per hr
 26° grav
 Comp.
 1932 O.W.D.D.
 10/19- Old TD 3447
 10/26- Top Pelic line 3447
 S.D. 3464 HFW
 11/2- TD 3474 plug back
 11/9- TD 3474
 P.B. 3463
 Well put on pump
 11/16- S.D. 3463' may abandon
 11/23 —

Map No. Kansas Sec. 21 Twp. 8 R. 19^w

Well No. 1- Silvers Farm

H. H. Woysens et al Company


 Ft. from N. Line

1320 Ft. from S. Line

1320 Ft. from E. Line

 Ft. from W. Line

1932

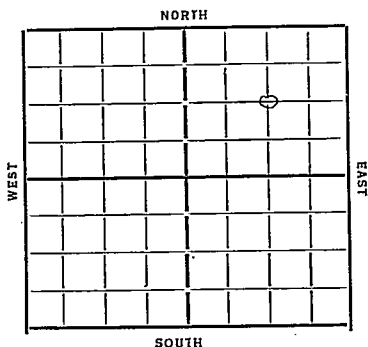

Date

REPORT

11/30

TD 3474

1213 3463 510

May abandon

12/7

12/14

12/21

12/28

Top Silic Line 3447

HFV 3464

TD 3475

Abandoned

Map No. **KANSAS** Sec. 21 Twp. 5 R. 19WWell No. 1 SilverH. K. Boyer & Co. Company

Contractor


SECTION PLAT

1320 Ft. from N. Line

Ft. from S. Line

1320 Ft. from E. Line

Ft. from W. Line

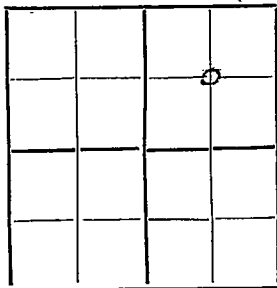

FIRST REPORTS

Location ✓

Rig up

Drilling and Remarks:

4000' Test

RECORD

Cased _____ in., _____ ft.

Sand _____

Gas _____

Oil _____

Total Depth _____

PRODUCTION

1st 24 hrs. Nat. _____

1st 24 hrs. after shot _____

Gas _____ Cu. Ft.

Dry Hole _____

Abandoned _____


Date

MAY 7 1930S. J. LEWIS Scout

Map No. **KANSAS** Sec. 21 Twp. 8 R. 19 W
65
 Well No. 1 Silver

H. T. Boyer & Co Company
 Contractor

SECTION PLAT

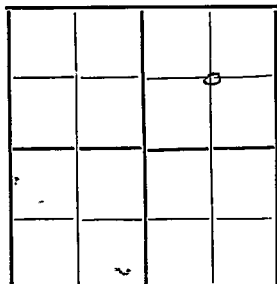

1320 Ft. from N. Line

..... Ft. from S. Line

1320 Ft. from E. Line

..... Ft. from W. Line

COMPLETED

Location.....

Rig up.....

Drilling and Remarks:

swab 20.88 per
hr. 26.2 gravity

RECORD

Cased..... in., ft.

Sand 3435-40

Gas.....

Oil.....

Total Depth 3445

PRODUCTION

1st 24 hrs. Nat.....

1st 24 hrs. after shot.....

Gas..... Cu. Ft.

Dry Hole.....

Abandoned.....

Date

NOV 12 1930
 192

S. J. LEWIS Scout

65 *Reck*
Map No. KANSAS Sec. 21 Twp. 8 R. 19W

Well No. 1- Silvers

Boyson et al Company

Contractor

FIRST REPORTS

1320 Ft. from N. Line

..... Ft. from S. Line

1320 Ft. from E. Line

..... Ft. from W. Line

SECTION PLAT

Location Cen 7 E

Rig up

Drilling and Remarks:

OW 10-10

RECORD

Cased in., ft.

Sand

Gas

Oil

Total Depth 3447

PRODUCTION

1st 24 hrs. Nat.

1st 24 hrs. after shot

Gas Cu. Ft.

Dry Hole

Abandoned

Date

OCT 1 9 1932

192

Sherwood Scout

Books

65 KANSAS Map No. Sec. 21 Twp. 8 R. 19 W

Well No. 1 Silvers

Beyson et al Company

Contractor

COMPLETED


1320 Ft. from N. Line

Ft. from S. Line

1320 Ft. from E. Line

Ft. from W. Line

SECTION PLAT

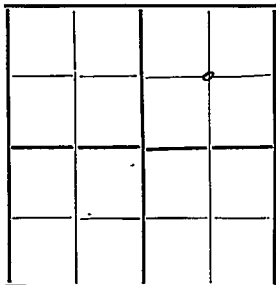

ABANDONED

Location

Rig up

Drilling and Remarks:

Top Siliceous 3447

HFW 3464

RECORD

Cased in., ft.

Sand

Gas

Oil

Total Depth 3475

PRODUCTION

1st 24 hrs. Nat.

1st 24 hrs. after shot

Gas Cu. Ft.

Dry Hole ✓

Abandoned ✓

Date

DEC 28 1932

192

CHAS. L. SHERWOOD

Scout