


Section 21 Township 8 Range 19-W

Well No. #1 Silvers

Company W. L. Hartman

NORTH Webster Pool

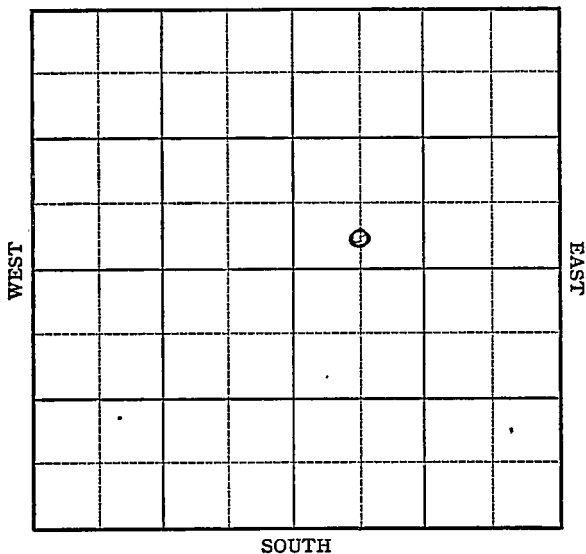

Sec. 21 Twp. 8 R. 19-W

Well No. #1 Silvers Farm

W. L. Hartman Company

(Webster Pool)


_____ Ft. from N. Line

330 Ft. from S. Line

_____ Ft. from E. Line

660 Ft. from W. Line

Elev. 2037

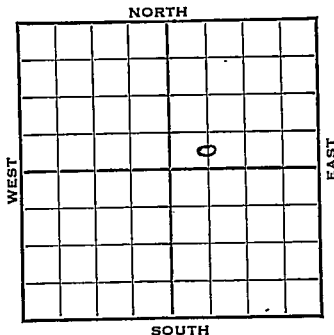

1942	REPORT
7/22	Spud 6/26/42 10" - 120' Waiting on cement
7/29	" " "
8/5	" " "
8/12	" " "
8/19	Drlg. 2150'
8/27	Topeka 2914 Lans 3214 Coring 3234
9/2	No report.
9/9	Arb. 3483 T.D. 3492
	No shows. ABANDONED

KANSAS

Form 26 200 Bks. 5-41 McW.

Map No. 65 Sec. 21 Twp. 8 R. 19W

Well No. 1 Silvers
W. L. Hartman Company
Contractor

FIRST REPORT

C SL SW NE

 Ft. from N. Line
330 Ft. from S. Line
 Ft. from E. Line
660 Ft. from W. Line

SECTION PLAT

WEBESTER POOL

Location _____
Rig up _____
Drilling and Remarks:

Spud 6/26/42
10" - 120'
Waiting on
cement

RECORD

Cased _____ in., _____ ft.
Sand _____
Gas _____
Oil _____
Total Depth _____

PRODUCTION

1st 24 hrs. Nat. _____
1st 24 hrs. after shot _____
Gas _____ Cu. Ft.
Dry Hole _____
Abandoned _____

Date

JUL 22 1942 19

S. J. LEWIS Scout

Rooks

KANSAS

Map No. 65 Sec. 21 Twp. 8 R. 19W

Well No. 1 Silvers

W. L. Hartman Company

ABANDONED Contractor

C SL SW NE

_____ Ft. from N. Line

330 Ft. from S. Line

_____ Ft. from E. Line

660 Ft. from W. Line

SECTION PLAT

WEBESTER POOL

Location _____

Rig up _____

Drilling and Remarks:

Cur 3483

No. holes

RECORD

Cased _____ in., _____ ft.

Sand _____

Gas _____

Oil _____

Total Depth 3492

PRODUCTION

1st 24 hrs. Nat. _____

1st 24 hrs. after shot _____

Gas _____ Cu. Ft.

Dry Hole _____

Abandoned _____

Date

SEP 9 1942 19

S. J. LEWIS Scout