
FORM 51 25M 8-50 WESTERN Rooks KANSAS

Section 21 Township 8 Range 19W

Well No. #3 Silvers

Company Alward & Derby Oil

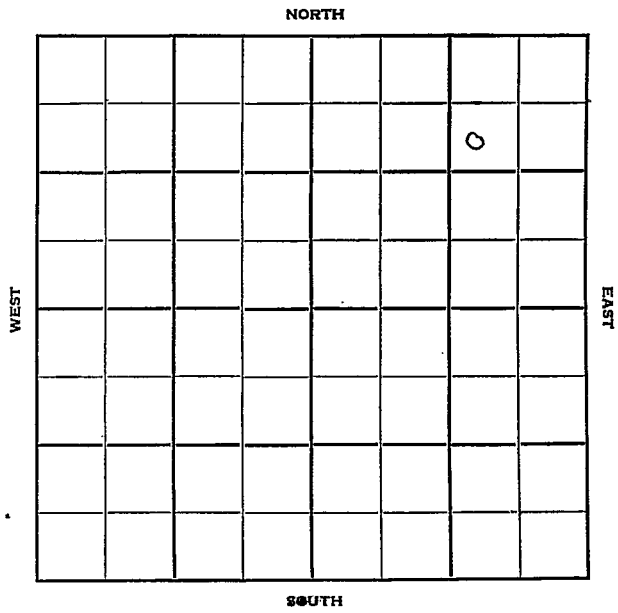

FORM 252-B
10M 10-50 PETROL

Rooks

KANSAS

Sec. 21 Twp. 8 R. 19 W

Well No. #3 Silvers Farm

Alward & Derby Oil Company

Contractor

Webster


1200 Ft. from N. Line

~~330~~ Ft. from S. Line

1200 Ft. from E. Line

~~330~~ Ft. from W. Line

~~SW SW NE~~
SW NE NE

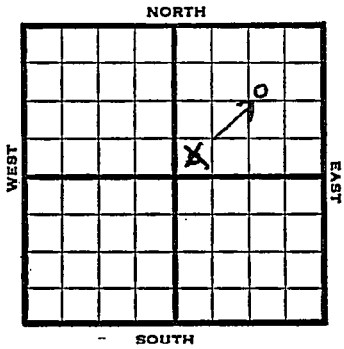

1952	Elev. 2010' REPORT
1/9	Location
2/6	Anhy 1444 Heeb. 3154 KC 3181 Arb. 3444 5" @ 3445 500 A S/ 15 BF 1 hr. 50% wtr. POP
2/13	No report
2/20	"
2/27	Spud 1-9-52 Oil Well TD 3450 8" @ 163 Anhy 1444 Heeb. 3154 KC 3181 DST 3161-3210 open 1 hr. rec. 115' socw & mud 60' vsocm & sw DST 3216-82 open 1 hr. rec. 270' vso & gcsw Arb. 3444 DST 3440-49 open 90 minute rec. 25' oil 35' ocm 5" @ 3444 DST 3442-49 open 90 min. rec. 25' 35' ocm 5" @ 3445 TD 3450 500 A S/ 15 bf 1 hr. 50% wtr Comp. 50 bopd 45% wtr.

COMPLETED

FORM 275 FOR SALE BY KANSAS BLUE PRINT CO.


County Rooks State Kansas

Sec. 21 (Blk. Twp.) 8 (Sur. Rge.) 19W Map No.

Operator Alward & Derby Oil

Well No. 3 Farm Silvers

Elev. Location SW SW NE

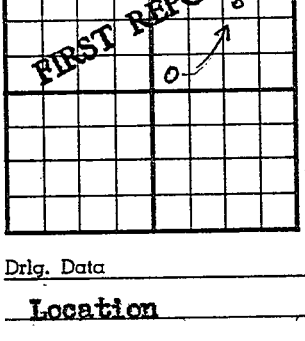

330 Ft. From S Line NE

330 Ft. From W Line Quarter

1st. Report JAN 9 1952

Completion

Remarks See Correction

Spudding Date

Drlg. Data Webster

Location

J. E. TYRA

Form 26 2200 Bks. 8-50 Petrol

Kansas

Map No. _____ Sec. 21 Twp. 8 R. 19W

Well No. 3 Silvers

Aylward & Derby Oil Company

CORRECTION Contractor

SW NE NE


1200 Ft. from N. Line

_____ Ft. from S. Line

1200 Ft. from E. Line

_____ Ft. from W. Line

SECTION PLAT

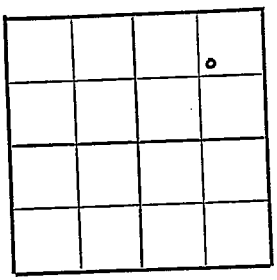

Rooks County

Location _____

Rig up _____

Drilling and Remarks:

Reported

SW SW NE

RECORD

Cased _____ in., _____ ft.

Sand _____

Gas _____

Oil _____

Total Depth _____

PRODUCTION

1st 24 hrs. Nat. _____

1st 24 hrs. after shot _____

Gas _____ Cu. Ft.

Dry Hole _____

Abandoned _____

Date

JAN 9 1952

19 _____

J. E. TYRA

Scout

FORM 275 FOR SALE BY KANSAS BLUE PRINT CO.


County Rooks State Kansas

Sec. 21 (Blk. Twp.) 8 (Sur. Rge.) 19W Map No.

Operator Aylward Drlg. & Derby Oil

Well No. 3 Farm Silvers

Elev. 2010 Location SW NE NE

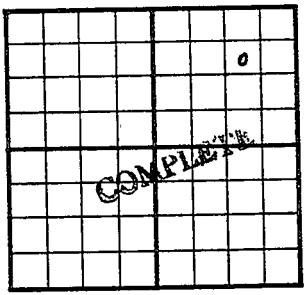

1200 Ft. From N Line NE

1200 Ft. From E Line Quarter

1st. Report

Completion FEB 27 1952

Remarks Webster Pool

Spudding Date 1-9-52

Drlg. Data Oil well TD 3450

8" @ 163 Anhy 1444 Heeb. 3154

KC 3181 DST 3161-3210 open 1 hr.

Rec. 115' socw & mude 60' vsocm & sw

DST 3216-82 open 1 hr. Rec. 270' vso &

gcsw Arb. 3444 DST 3442-49 open 90 mi

Rec. 25' oil 35' ocm 5" @ 3445

TD 3450 500 A S/ 15 bf 1 hr. 50% water

Comp. 50 bopd 45% water

J. G. McGEHEE