


Section 21 Township 8 Range 19 W

Well No. # 1 Ververka

Company Geo. Siegrist

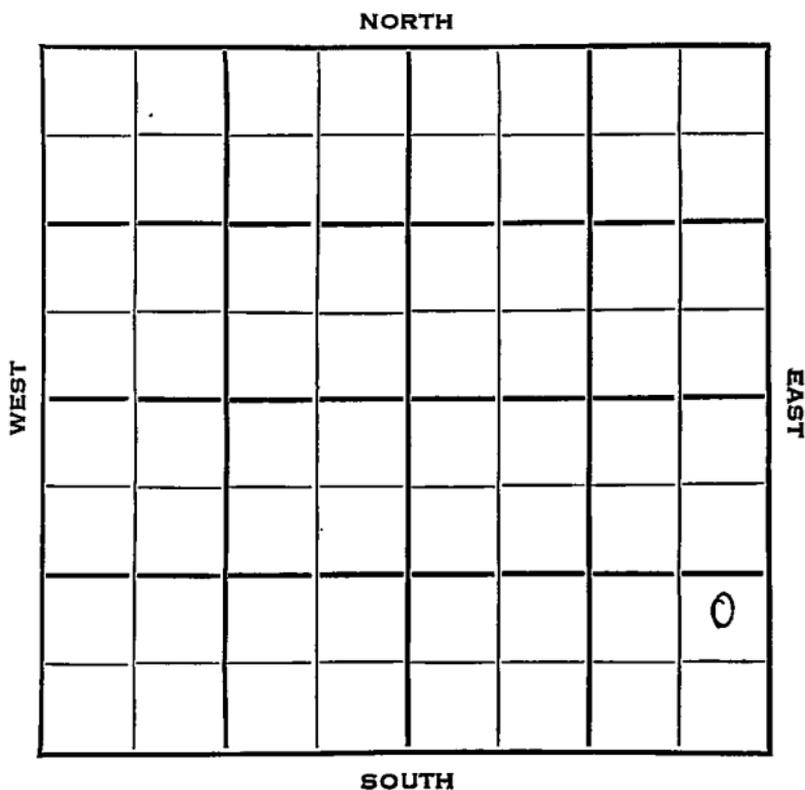

Rooks KANSAS


SEC.	TWP.	R.
21	8	19 W ✓

WELL NO. # 1 Ververka FARM

COMPANY Geo. Siegrist

CONTRACTOR Stearns Drlg.

_____ Ft. from N. Line
 990 _____ Ft. from S. Line
 330 _____ Ft. from E. Line
 _____ Ft. from W. Line

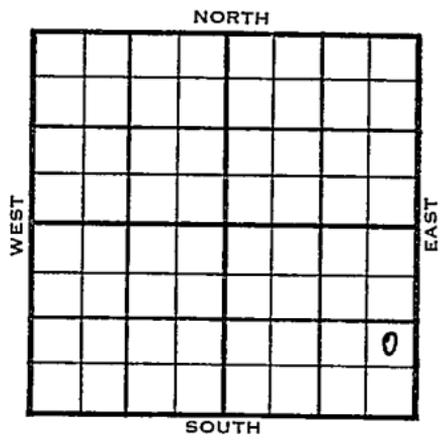

NE SE SE

1953	ELEVATION	REPORT
	1996'	
12/22		Drlg.
1954		
1/6	Anhy 1410'	Arb. 3429'
	RTD 3434'	5" @ 3431
1/13	DD 3436'	500 A AFW PB
1/20		NR
2/10		NR
3/10		NR
4/28	Spud 12-22-53	
	D&A	
	TD 3436'	
	8" @ 247'	
	Anhy 1410', Top 2940', Heeb 3146',	
	Tor 3168', Lans 3186', Arb. 3429'	
	TD 3434'	
	5" @ 3431'	
	DD 3436 HFW	
	PB 3300'	
	12/3284-88	
	B/1 boph 2000A 2 boph	
	P/5½ bopd	
	D&A	

ABANDONED

Joe,

Please check the range on this one.
You reported it in 19W & comp. in 17W.

Louville

Scout Cards	
Land Small Map	
Land Wall Map	
Tracings	
France Map	
Pierce Map	
Misc.	

Do

3

MAY 6 1954

Orig. Data