


Section 21 Township 8 Range 19W

Well No. 1 Ververke

Company Northern Pump

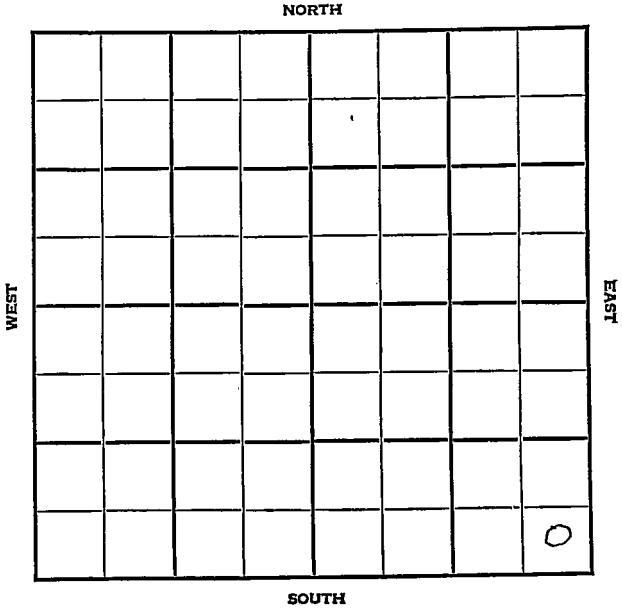

Sec. 21 Twp. 8 R.

Well No. #1 Ververka Farm

Northern Pump Company

Webster Pool


Ft. from N. Line

330 Ft. from S. Line

330 Ft. from E. Line

Ft. from W. Line

SE/C.

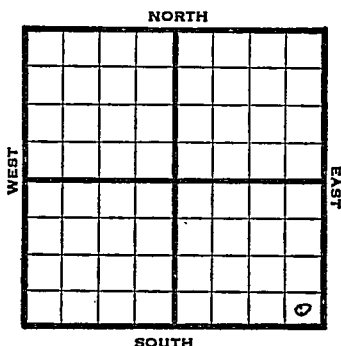

1948 Elev. 2002: REPORT

8/4 8" @ 143'
Anhy 1400'
Dr1g 1600'
8/11 Lansing 3178'
Arbuckle 3432'
TD 3437'
5" @ 3435'
8/18 "
8/25 1800' oil 12 hrs.
9/1 "
9/8 "
9/14 "
9/21 "
9/29 "

10/6 Arbuckle 3432'
5" @ 3435'
Pump 142 oil & 60% W Pot.
Gr. 27°
TD 3437'

COMPLETED

Rooks County Kansas State

Map No. _____ Sec. 21 Twp. 8 R. 19W

Well No. 1 Ververka


Northern Pump Company

FIRST REPORT

SE/C

Contractor

SECTION PLAT

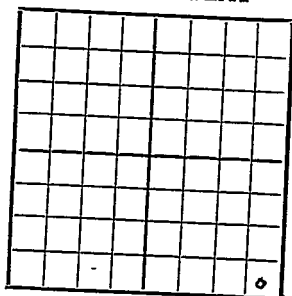

_____ Ft. from N. Line

330 Ft. from S. Line

330 Ft. from E. Line

_____ Ft. from W. Line

Webster Pool

Remarks:

8" @ 143 Anhy 1400 drlg. 1600

Date
AUG 4 1948

Scout S. J. LEWIS

Map No. 65 Sec. 21 Twp. 8 R. 19WWell No. 1 Ververka

Northern Pump

Company

COMPLETE

SE/C

Contractor

E. 2002
SECTION PLAT

Ft. from N. Line


330

Ft. from S. Line

330

Ft. from E. Line

Ft. from W. Line

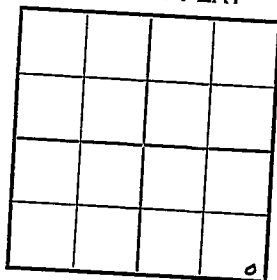

Rooks County

Location

Rig up

Drilling and Remarks:

C 3432.

5' @ 3435

Pump 142 oil 6 + 60%
W 27.

27 2/3

RECORD

Cased _____ in., _____ ft.

Sand _____

Gas _____

Oil ☒Total Depth 3437

PRODUCTION

1st 24 hrs. Nat. _____

1st 24 hrs. after shot _____

Gas _____ Cu. Ft.

Dry Hole _____

Abandoned _____

Date

OCT 6 1948 19

S. J. LEWIS Scout