


Section 21 Township 8 Range 19W

Well No. 1 Ververka "A"

Company Anderson-Prichard et al

Webster Pool
o

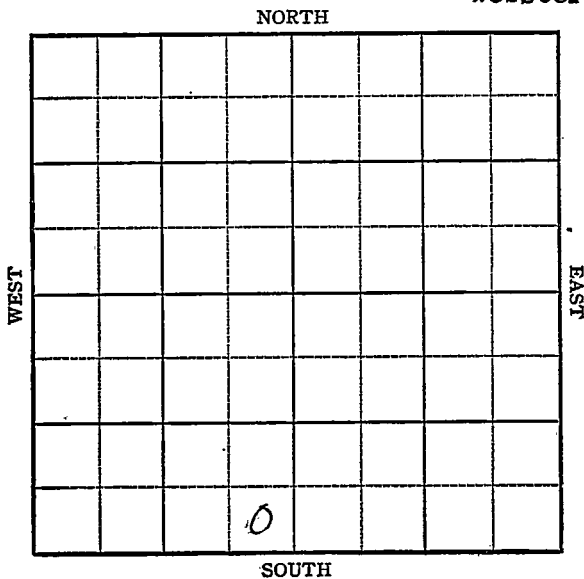

Sec. 21 Twp. 8 R. 19W

Well No. 1 Ververka "A" Farm

Anderson-Prichard et al Company
Webster Pool


 Ft. from N. Line

330 Ft. from S. Line

330 Ft. from E. Line

 Ft. from W. Line

SE SW

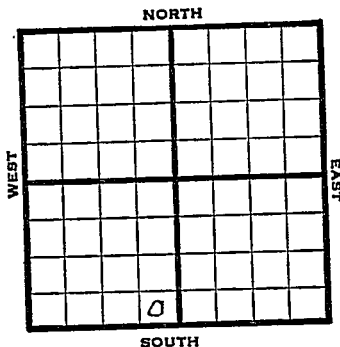

1948

Elev. 2033'

REPORT

9/1

RUR

9/8

8" @ 1465'
Drlg 2396'

9/14

Lansing 3219'
Drlg 3321'

9/22

Congl 3489'
Arb 3518'
TD 3545'

$$\begin{array}{r}
 3518 \\
 2033 \\
 \hline
 1485
 \end{array}$$

ABANDONED

