


Section 21 Township 8 Range 17 W

Well No. # 1 Stamper "A"

Company Petroleum Inc.

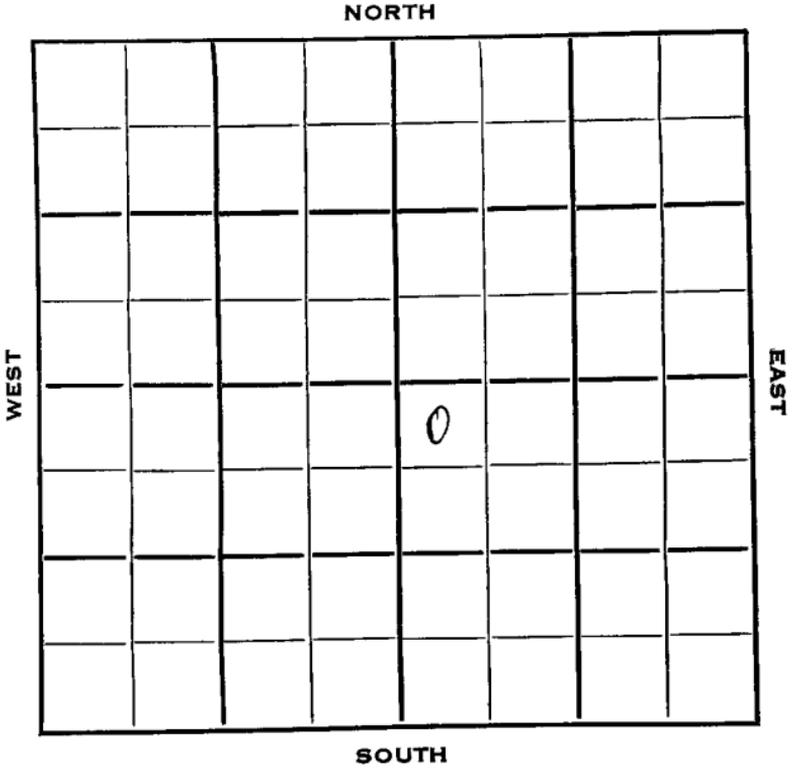

Rooks

KANSAS ✓

SEC.	TWP.	R.
21	8	17 W

WELL NO.

1 Stamper "A"

FARM

COMPANY

Petroleum Inc.

CONTRACTOR

Petroleum Inc.


Wildcat

330 Ft. from N. Line

Ft. from S. Line

Ft. from E. Line

330 Ft. from W. Line

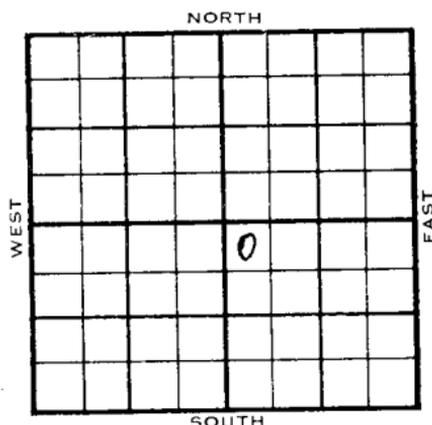NW NW SE
Texas - DHM

ELEVATION

REPORT

1953

1944'

Arb. test

12/22

Spud 12-19-53

8" @ 200

Drlg. 2000'

1954
1/6

Spud 12-19-53 D & A TD 3530
 8" @ 200 Heb 3088 Lans. 3128
 DST 3348-64 open 3/4 hr, rec 22' mud
 880# Cong. 3424 TD 3530
 D & A

ABANDONED

County Rooks State Kansas
 Sec. 21 (Blk. 8) (Sur. 17W) (Twp.) (Rge.) Map No.
 Operator Petroleum Inc.
 Well No. 1 Farm Stamper "A"
 Elev. 1944 Location NE NW SE

ABANDONED									

330 Ft. From N Line SE
330 Ft. From W Line Quarter
 Ist. Report
 Completion JAN 6 1954
 Remarks Wildcat
Petroleum Inc. - Contr.
 Spudding Date 12-19-53

Dfg. Data D & A TD 3530
8" @ 200 Heeb. 3088 Lans. 3128
DST 3348-64 open 3/4 hr. Rec. 22' mud
880# Cong. 3424 TD 3530
D & A