

Section 21 Township 8 Range 25 WWell No. # 1 SchmeidCompany Bay Petroleum

NORTH

				0			

10

Graham

KANSAS

Sec. 21

Twp.

8

R.

25W

Well No. #1 Schmeid Farm

Bay Petroleum Company

Anschutz- Contr. Contractor

Wildcat


330' Ft. from N. Line

Ft. from S. Line

Ft. from E. Line

330' Ft. from W. Line

NW NW SE

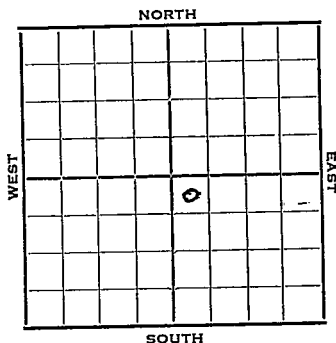

1952

Elev. 2384' REPORT

3/19
3/25

MIR

8" @ 270'

Anhy 2135

Drlg. 2530

4/1

Topeka 3455

Heeb. 3675

Tor. 3696

Land. 3717

DST 3735-51, 1 hr. 215' oil

220' SOCM 900#

DST 3783-3800, 1 hr. 2035' SOC SW
1330#

DST 3831-45, 1 hr. 51 mco 1150#

DST 3876-95, 1 hr. 30' bil, 60'

SOCM 450' gas 1500#

Drlg. 3990'

4/9

Sch tops: Topeka 3452 Heeb. 3675

Lans. 3719 Cong. 4235

Miss Chat 4251 Miss Li 4287

V. 4328 Arb. 4403

TD 4474 Sch

5" @ 3948, WOC

4/22

12/3878-81 36 gal OPH for 9 hrs.

1000 A 10 BOPH PB 3870'

24/3838-44 S/10 BOPH for 2 hrs.

PB 3810' 24/3740-44 Fill up 200'

oil & some water 500 A S/10 BOPH
for 4 hrs. POP

4/30

NR

OVER


1952

5/7 NR

5/14 Spud 3-19-52
Oil Well TD 4474
8" @270
Anhy 2135 Top. 3455 Heeb. 3675
Tor. 3696 Lans. 3717
DST 3735-53 opn 1 hr. Rec. 215' oil
220' smco DST 3783-3800 opn 1 hr.
Rec. 2035' socsw DST 3831-45 opn
1 hr. Rec. 30' oil 60' smco 450'
gas
Schlumberger Tops:
Top. 3452 Heeb. 3675
Lans. 3719 Cong. 4235
Miss Chat 4251 Miss lm 4287
Viola 4328 Arb. 4403
TD 4474
5" @ 3948 12/3878-81 36 goph 9 hr.
1000 A 10 boph PB 3870 24/3838-44
S/10 boph 2 hr. PB 3810
24/3740-44
FU 200' oil & some wtr. 500A
S/10 boph 4 hr. Comp. 68 bopd 5% wtr.

COMPLETED

County Graham State Kansas
 Sec. 21 (Blk. 8 (Sur. 25W Map No.
 (Twp.) (Rge.)
 Operator Bay Petroleum
 Well No. 1 Farm Schmeid
 Elev. Location NW NW SE

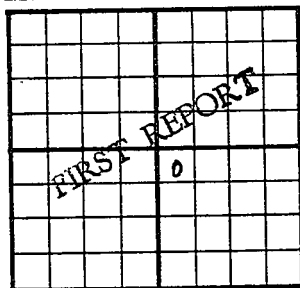

330 Ft. From N Line SE
330 Ft. From W Line Quarter
 1st. Report MAR 1 9 1952

Completion

Remarks

Anschutz - Contr.

Spudding Date


Drlg. Data

Wildcat

M I R

J. G. McGEHEE

County Graham State Kansas
 Sec. 21 (Blk.) 8 (Sur.) 25W Map No.
 Operator Bay Petroleum
 Well No. 1 Farm Schmeid
 Elev. 2384 Location NW NW SE

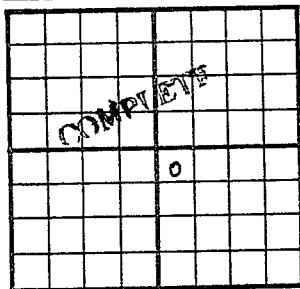

330 Ft. From N Line SE
330 Ft. From W Line Quarter
 1st. Report
 Completion MAY 14 1952
 Remarks Wildcat
Anschutz - Contr.
 Spudding Date 3-19-52

Drlg. Data Oil well TD 4474
8" @ 270 Anhy 2135 Top. 3455
Heeb. 3675 Tor. 3696 Lans. 3717
DST 3735-53 open 1 hr. Rec. 215' oil
220' smco DST 3783-3800 open 1 hr.
Rec. 2035' socsw DST 3831-45
open 1 hr. Rec. 30' oil 60' smco
450' gas SCHLUMBERGER TOPS
Top. 3452 Heeb. 3675 Lans. 3719
Cong. 4235 Miss. chat 4251 Miss. lime
4287 Viola 4328 Arb. 4403 TD 4474
5" @ 3948 12/ 3878-81 36 goph 9 hr.
1000 A 10 boph PB 3870 24/ 3838-44
S/ 10 boph 2 hr. PB 3810 24/ 3740-44

J. G. McGEHEE

Drlg. Data

FU 200' oil & some water 500 A

S/ 10 boph 4 hr. Comp. 68 bopd 5% water

